1814

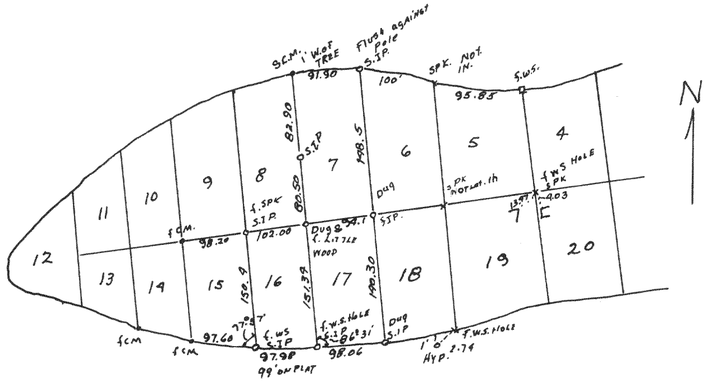

Survey lots 15, 16, 17, & 7 of Unit 1 Country Club Estates in the Village of Fontana, Walworth County.
Dec 17, 1948
July 6, 1948

Lloyd L Jensen
County Surveyor.
C.L.

1815

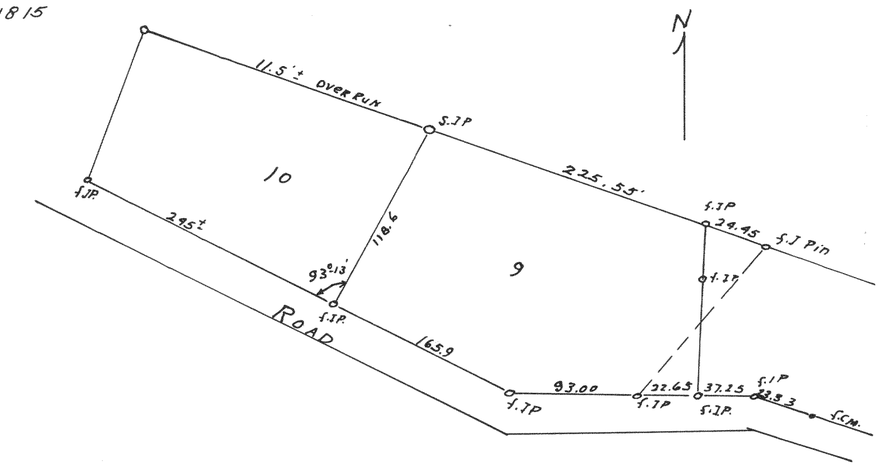

Plat of survey of Lot 9 in The Gardens, Village of Fontana, Walworth, County.
July 2, 1998

Lloyd. L. Jensen.
County Surveyor.
C.L.