
1816


LAKE GENEVE

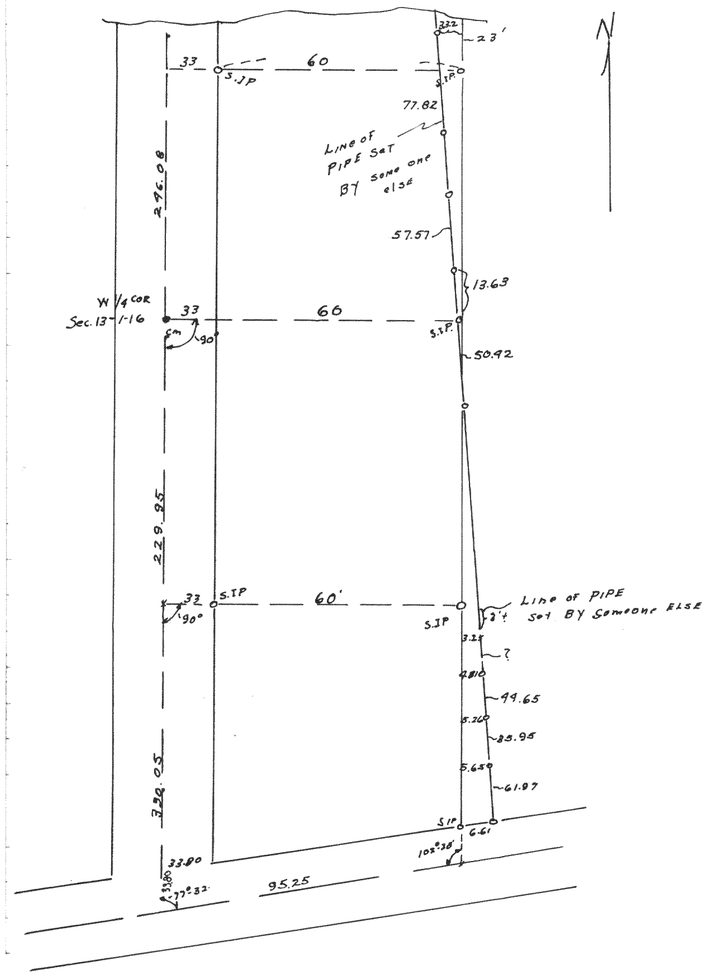

SURVEY OF OUTLOT 79 VILLAGE OF FONTANA, WALWORTH COUNTY.
1948

Lloyd L. Jenson
County Surveyor.
C.L.

1817

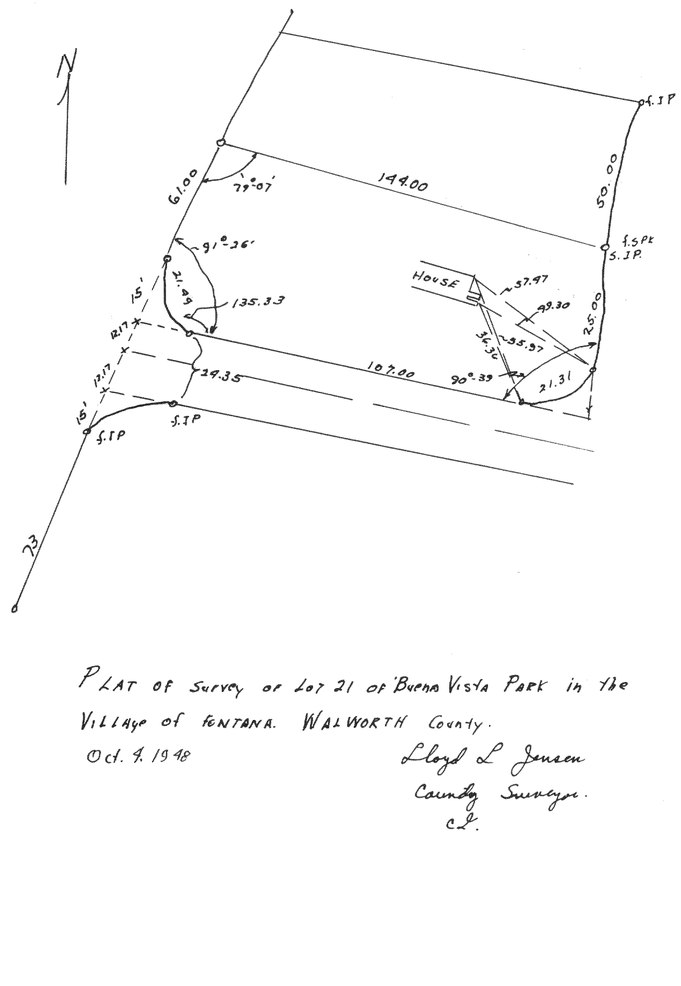

PLAT OF SURVEY OF LOT 21 OF BUENA VISTA PARK IN THE VILLAGE OF FONTANA. WALWORTH COUNTY.
Oct. 9. 1948

Lloyd L Jenson
County Surveyor.
C.L.