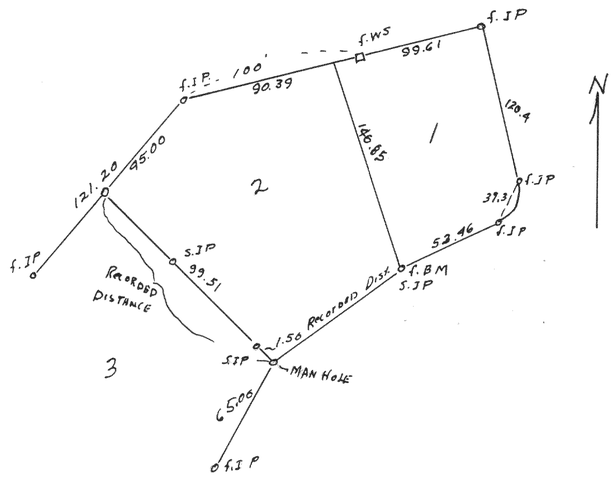
N 1818



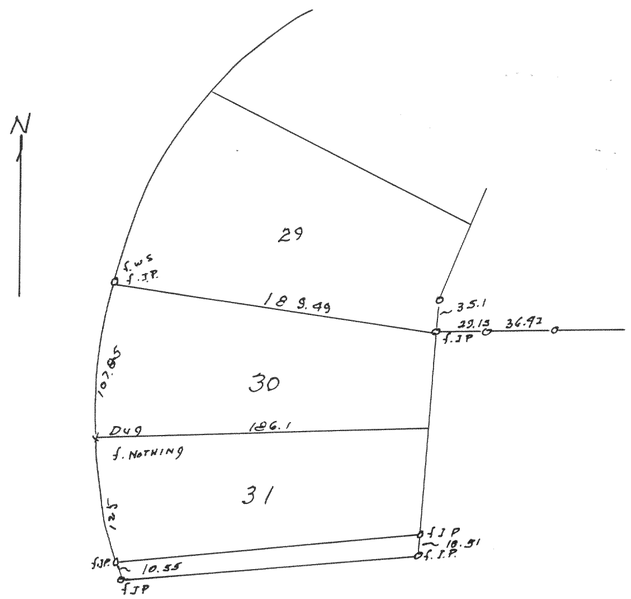

Plat of survey of Lot 2 Block C Country club Estates in the Village of Fontana, Walworth, County

Dec. 10, 1998

Lloyd L. Jensen
County Surveyor.
CL.



N 1819




PLAT of survey of lots 30 & 31 Unit 1 Country Club Estates in the Village of Fontana Walworth, County

Dec 21. 1998

Lloyd L Jensen
County Surveyor.
CL.