
330


1820

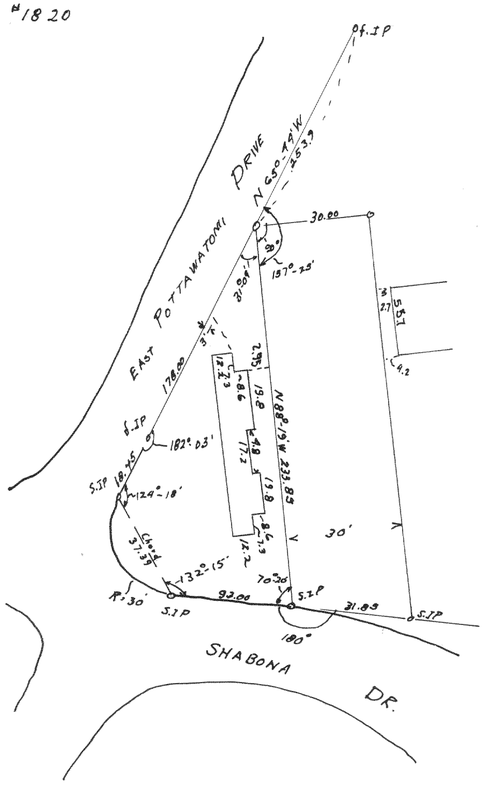

Plat of Survey of O.L 2 of Unit 3 Country Club Estate
Village of Fontana Walworth, County
Dec. 29, 1998

Lloyd L Jenson
County Surveyor
C.L.

1821

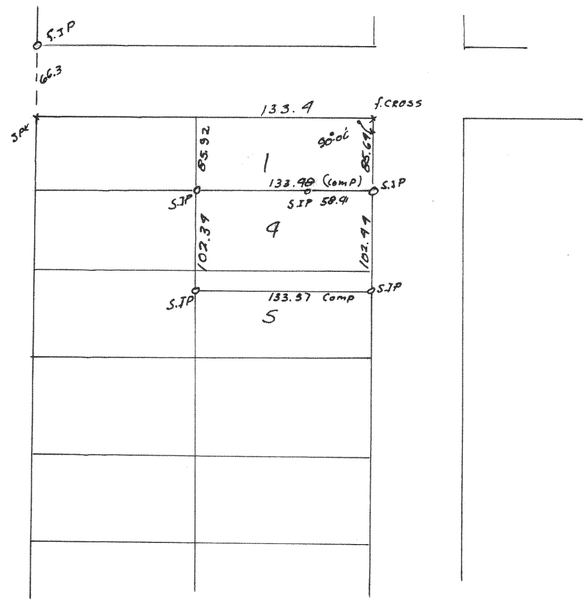

Plat of survey of Lot 4 & part of Lot 5 Block 30
of Prock wells addition in the City of Elkhorn, Walworth County
July 3. 1998

Lloyd L. Jenson
County Surveyor
CL.