
H 1822

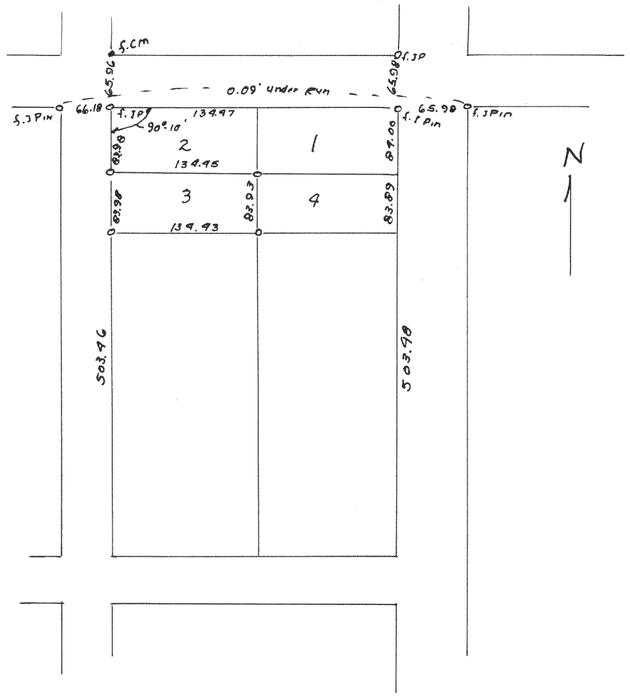


Plat of Survey of lot 3 of Davis Addition in the City of Elkhorn, Walworth County
Sept 7. 1998

Lloyd L. Jenson
County Surveyor
C.L.

331

H 1823

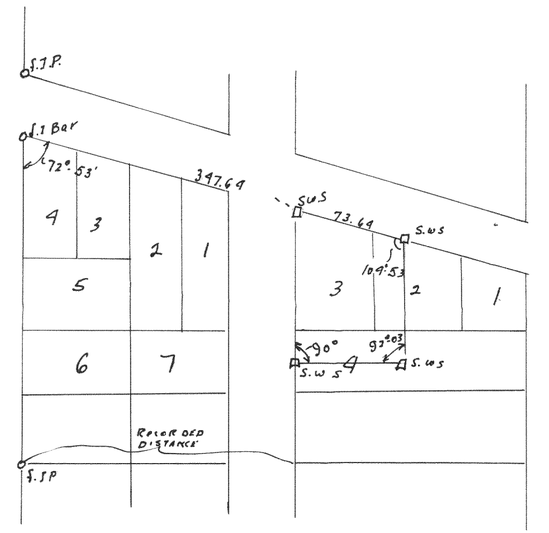

Plat of survey of parts of lots 2. 3, and 4 of Preston addition City of Elkhorn Wood stake marked of the lot owners. Walworth County
Sept 21. 1998

Lloyd L Jenson
County Surveyor
CL.