

1824

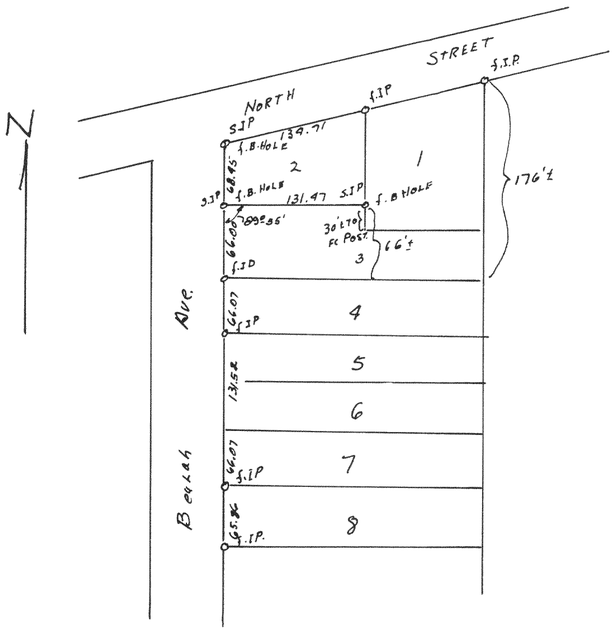

P lod of survey of lot 2 in Burlak Avenue Addition in the Village of East Troy. Walworth County.
June 26. 1998

Lloyd L Jenson
County Surveyor
cl.

1825

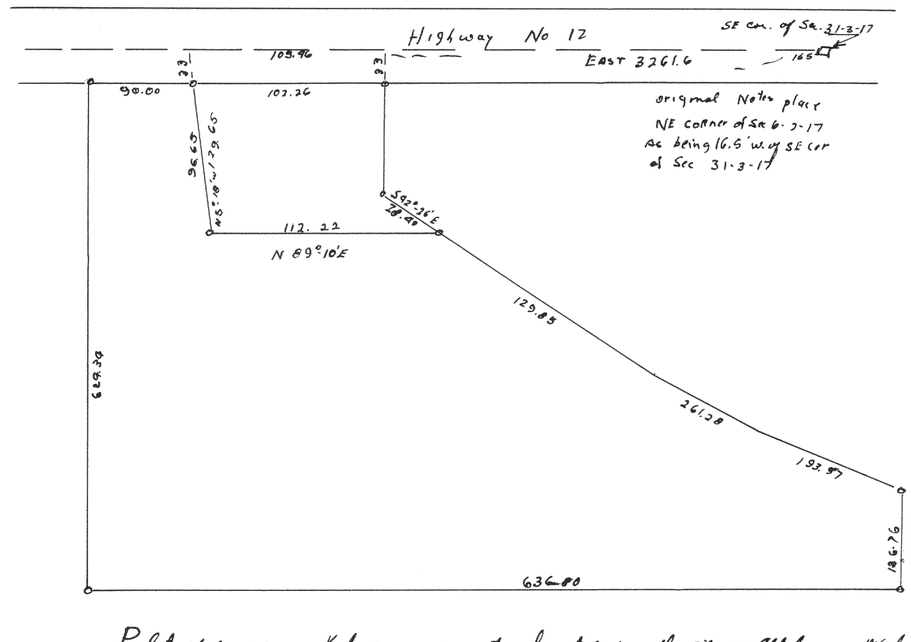

P lod of survey of Kalyman property located in the city of Elkhorn Walworth county
April 28.1998

Lloyd L. Jenson
County Surveyor
C.L.