
334


H 1828

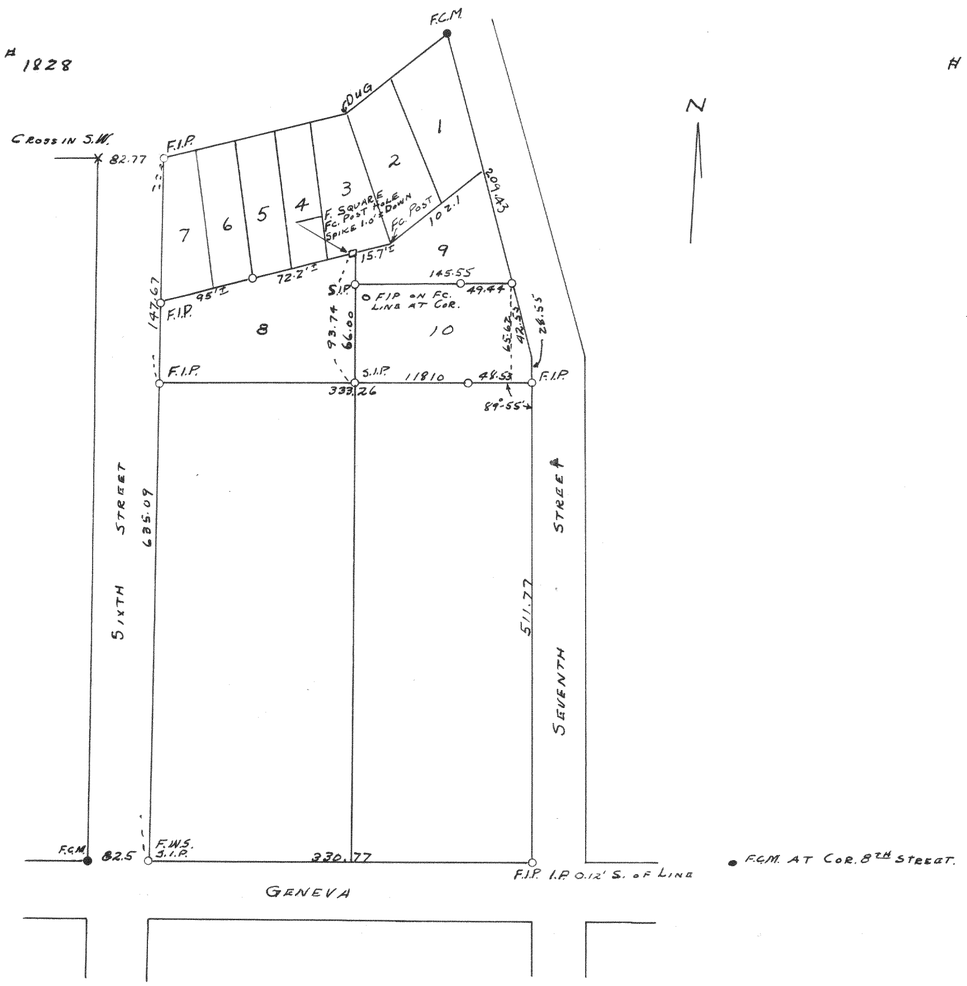

Survey of Lot 10 in Aron Downie's Addition
City of Delavan Walworth County.
Oct. 6, 1948

Lloyd L. Jensen
Cnty

H 1829

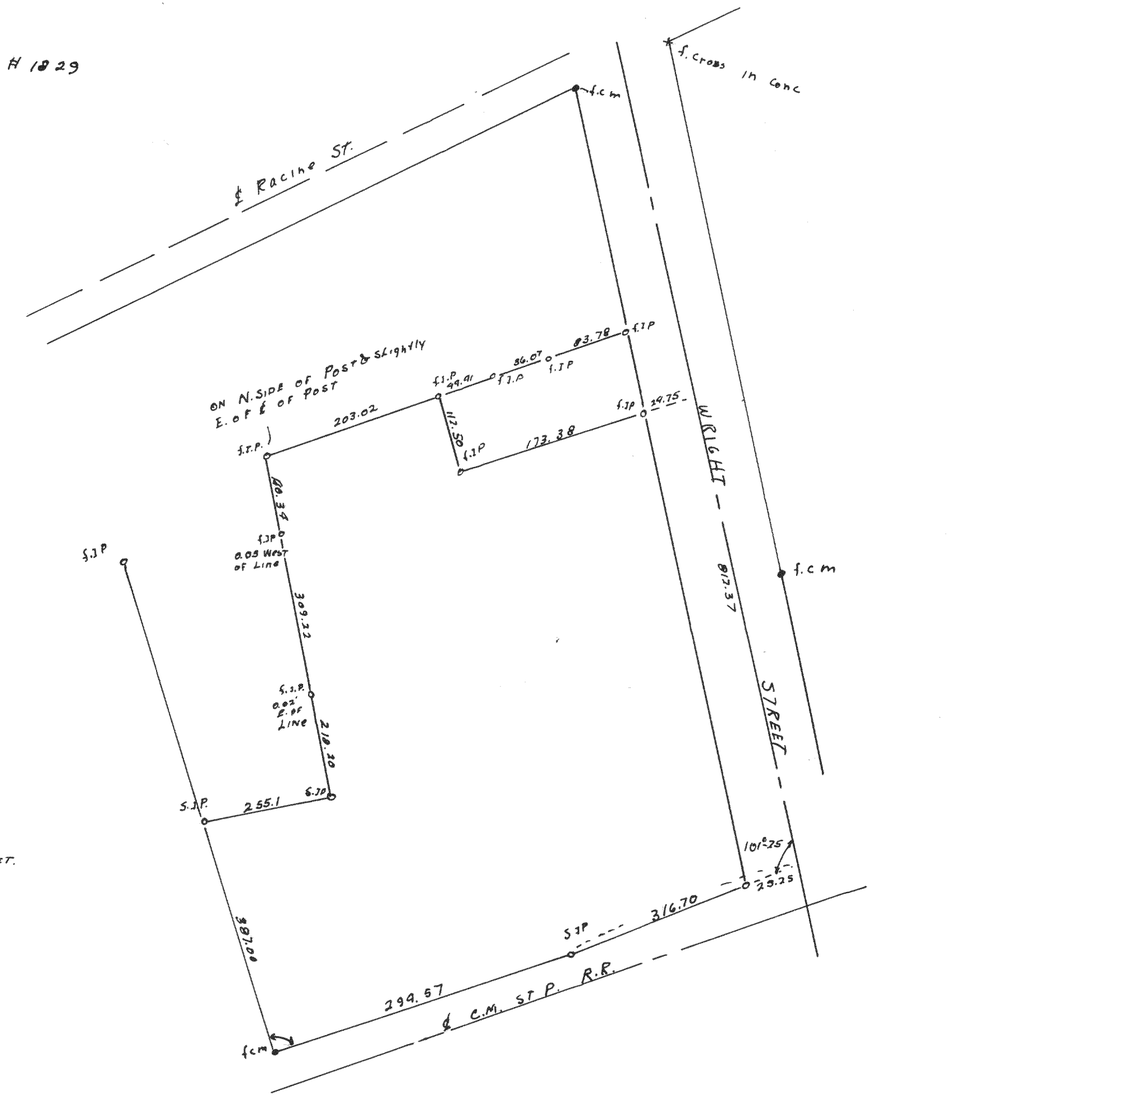

Plat of survey of parcel of land located in the City of Delavan, Walworth, County
Nov. 17, 1948

Lloyd L. Jensen
County Surveyor
Cnty.