
1830

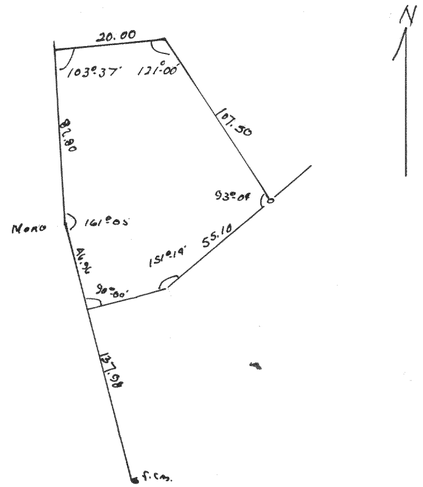


Plat of Survey of Lot 10 Block 10 of Lake Geneva Manor in the City of Lake Geneva Walworth County

June 16, 1948

Lloyd L Jensen
County Surveyor.
C.E.

1831

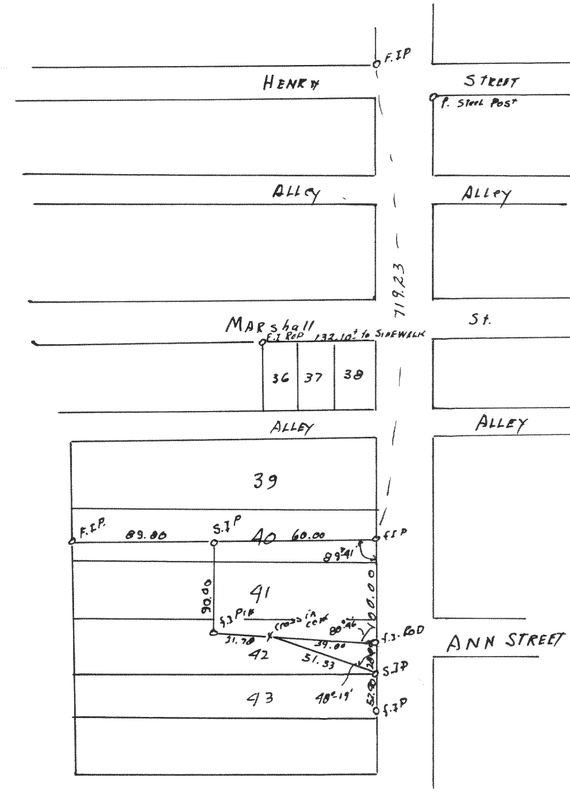

Plat of survey of Parts of lots 40, 41, and 42 of Kicks add in the city of Lake Geneva. Walworth County

Dec 11. 1948

Lloyd L Jensen
County Surveyor
C.E.