
336

1822

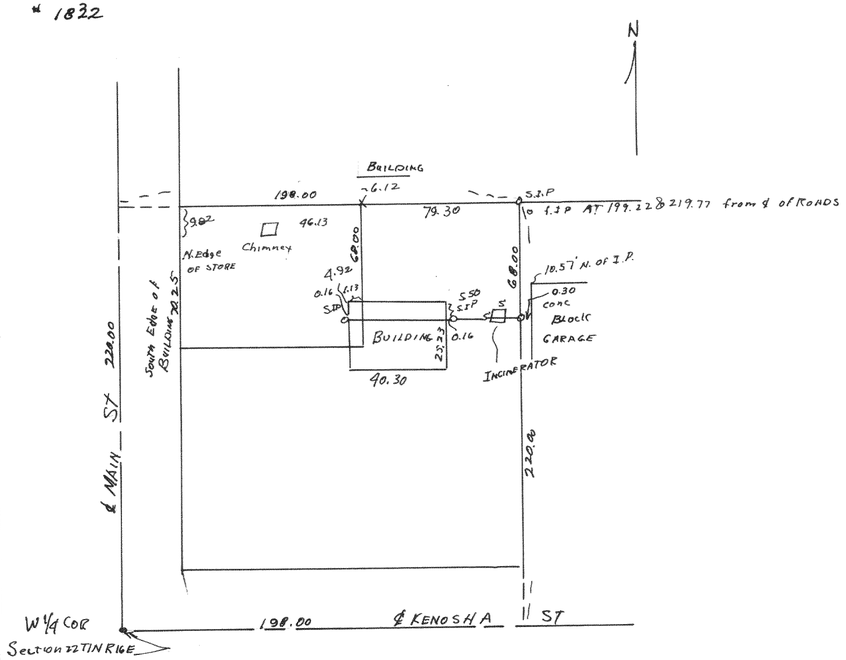


Plat of Survey of the North 68 ft of the East 79 ft of Lot 1 Block 1 Original Plat of the Village of Walworth, Walworth County

Dec. 28, 1998

Lloyd L Jensen
County Surveyor
CE.

1833

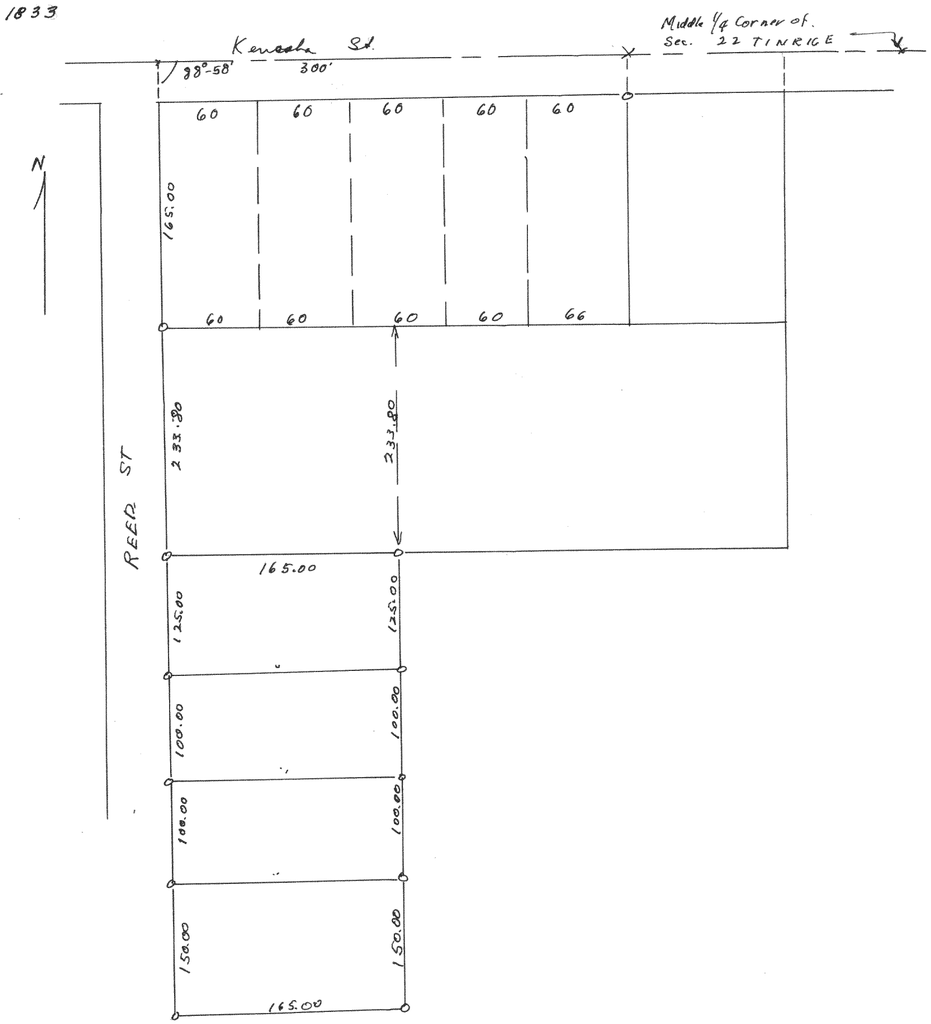

Plat of Survey of Parcel of land located in O.L. 218 in the Village of Walworth, Walworth County

Sept. 1998

Lloyd L Jensen
County Surveyor
CE.