

1834

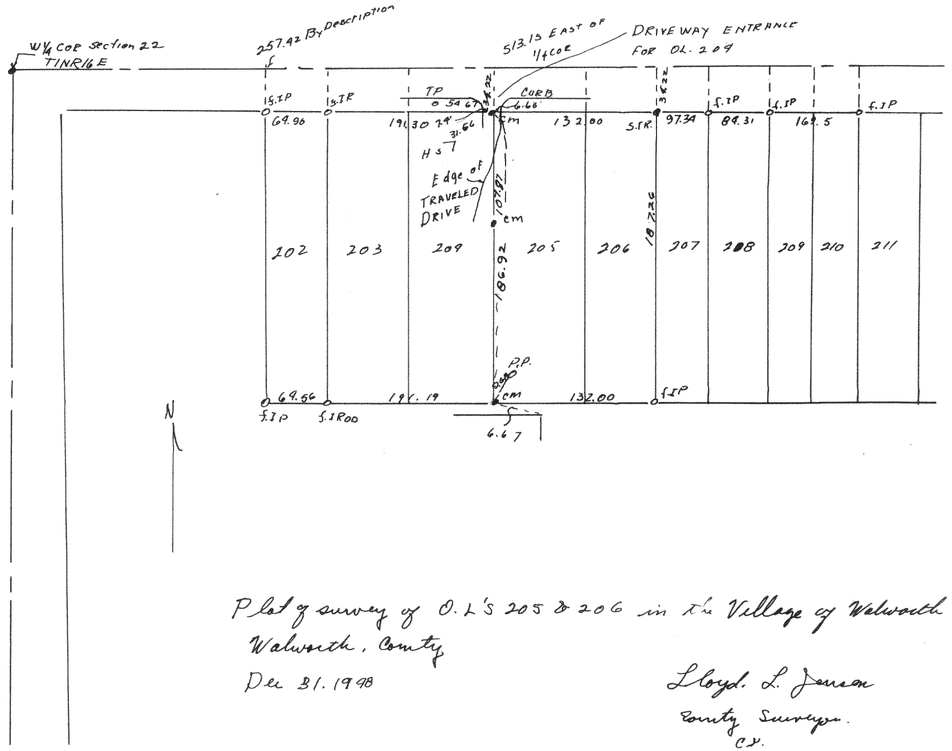

Plat of survey of O.L's 205 & 206 in the Village of Walworth
Walworth, County
Dec 31. 1998

Lloyd L. Jensen
County Surveyor.
C.S.

1835

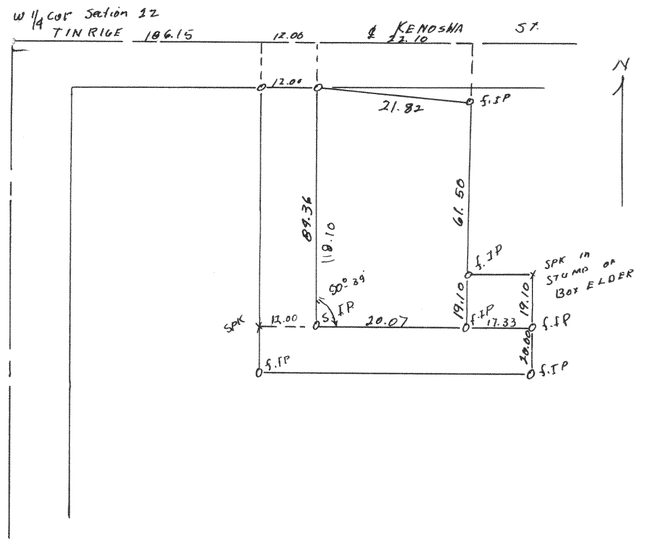

Plat of survey of part of O.L 201. Village of Walworth
Walworth County
74. 4. 1999

Lloyd L Jensen
County Surveyor.
C.S.