

1836

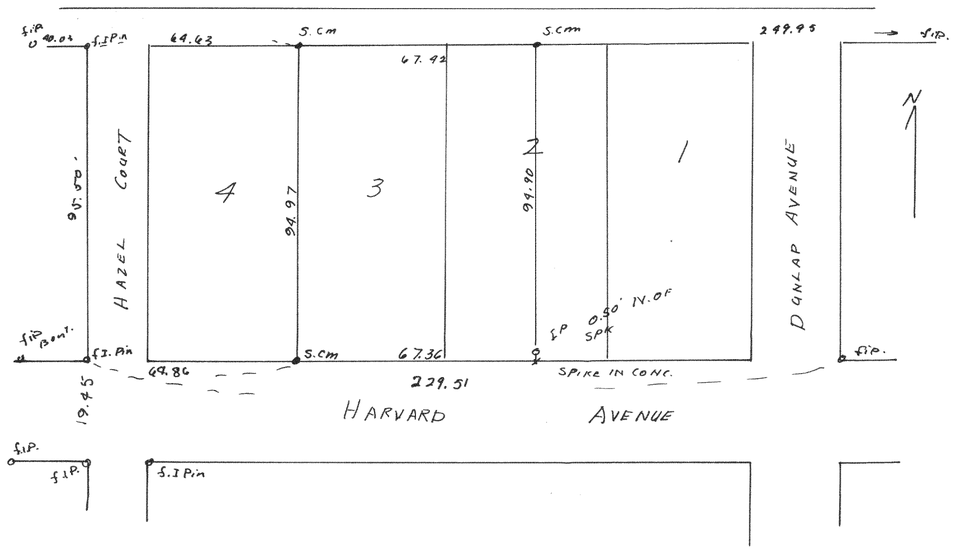

Plat of Survey of the W 1/2 of Lot 2 and Lot 3 Block 6 in Glenwood Springs, Village of Fontana, Walworth, County Oct. 1948.

Lloyd L. Jensen
County Surveyor.
C.S.

1837

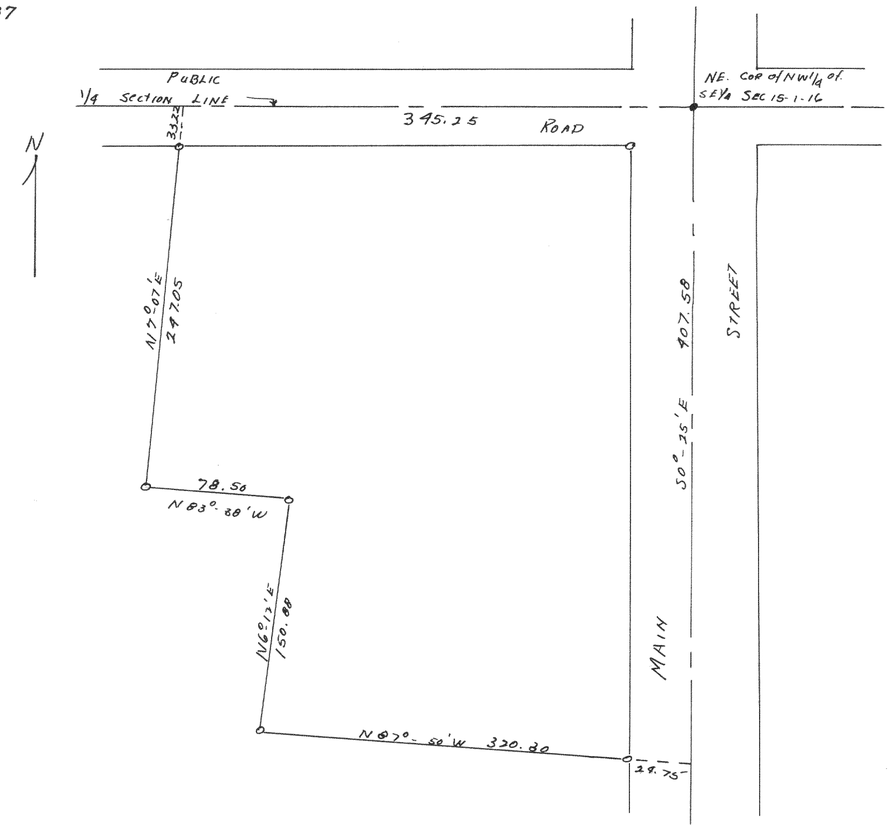

Plat of survey of part of Lot 19 of the Village of Fontana, Walworth County March 1948.

Lloyd L. Jensen
County Surveyor.
C.S.