
1838

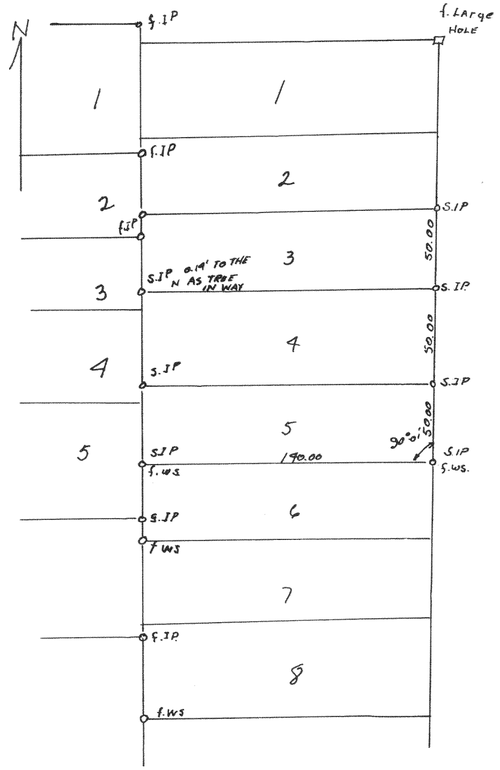


Plat of survey of lots 3,4,2,5 of Block 10 Moraine Subdivision on Potter Lake T4NR18E Walworth county

June 7. 1998

Lloyd L Jensen
County Surveyor.
cl

1839

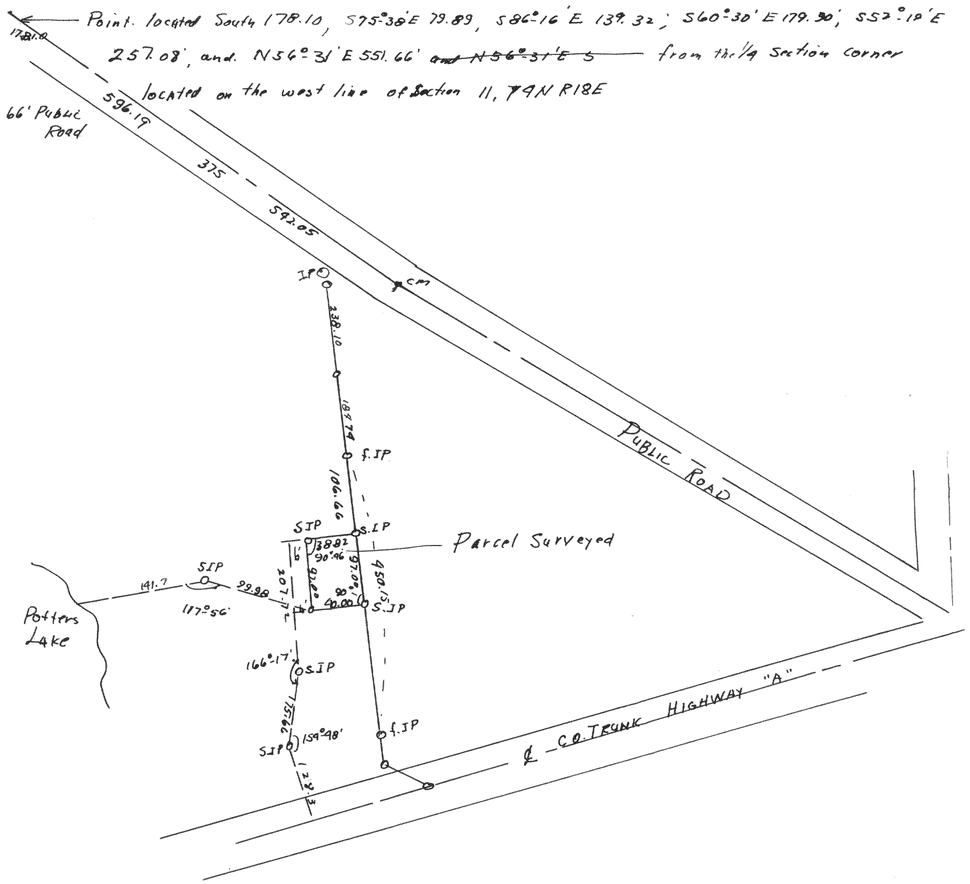

Plat of survey of parcel of land located in the West fractional 1/2 of Section 11, T4NR18E, Walworth County

Dec 8. 1998

Lloyd L. Jensen
County Surveyor
cl.