

1840

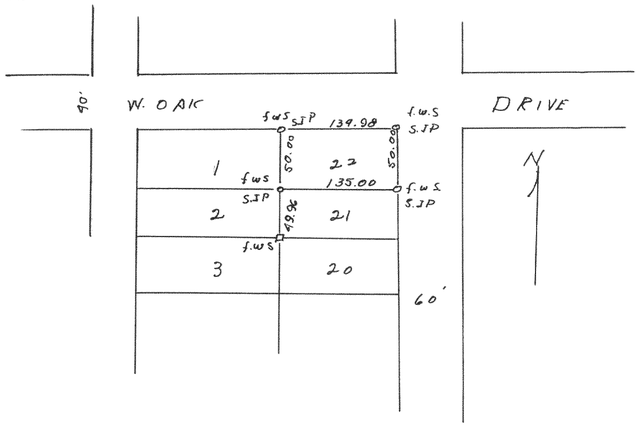

Plat of survey of lot 22 Block 6 in Miramar Subdivision Potlatch Lake T4NR18E Walworth county
June 16, 1998

Lloyd L Jensen
County Surveyor
C.L.

1841

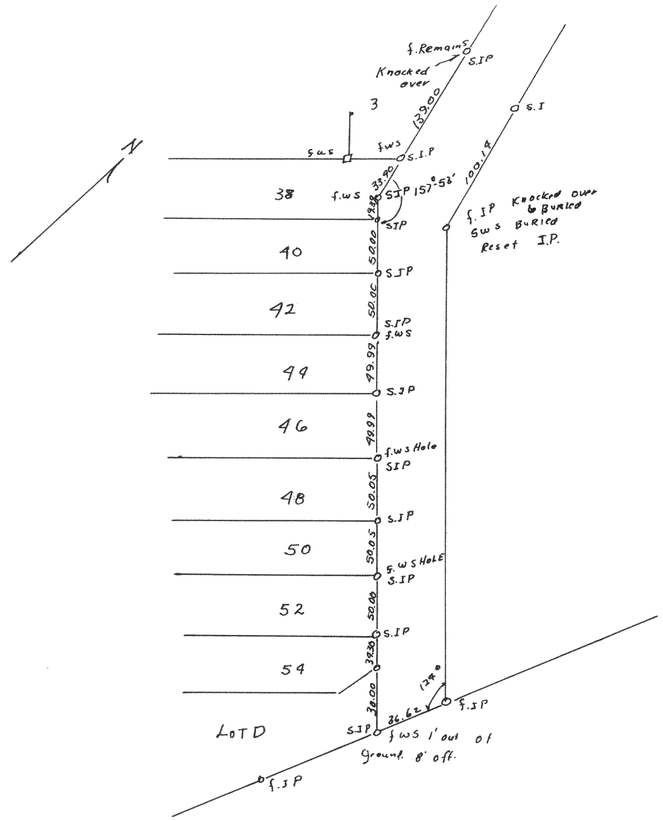

Plat of survey of the NE lot corner of lots 32, 38, 40, 42, 44, 46, 48, 50, 52, 54 of O-TON-KAH subdivision located in Section 10 T4NR18E Walworth county
July 2, 1998

Lloyd L Jensen
County Surveyor
C.L.