
1846

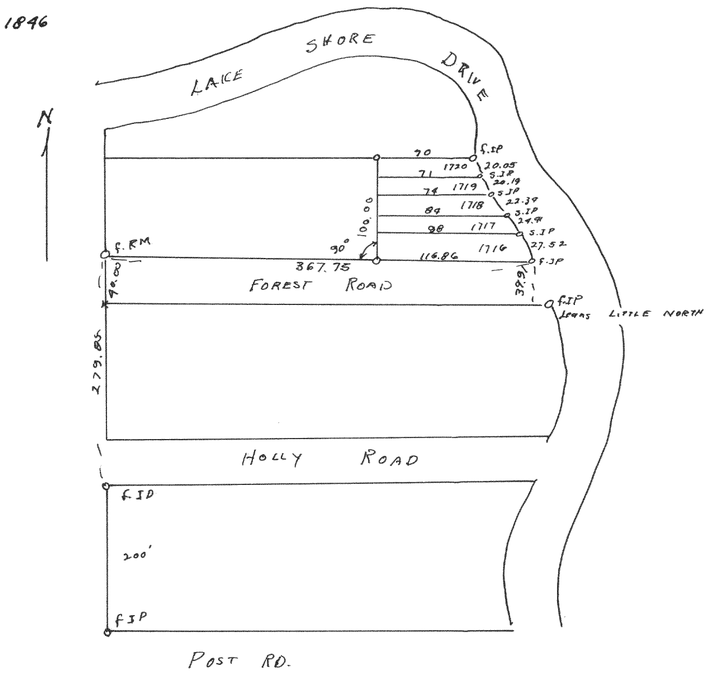


Post Rd.

Plat of survey of Lots 1716-1720 Pell Lake Subdivision in TINRIBE Walworth County.
June 4 1948

Lloyd L Jensen
County Surveyor
C.S.


1847

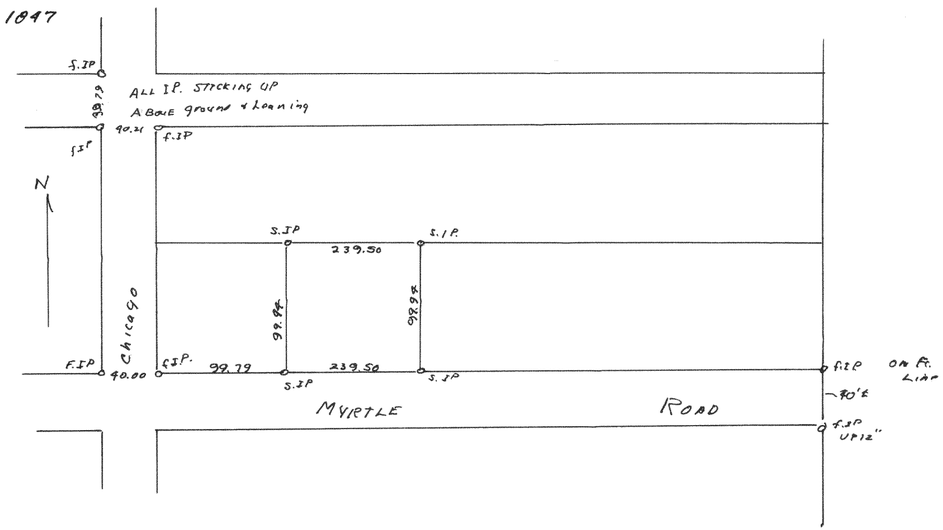

Plat of survey of lots 1025-1036 Pell Lake addition TINRIBE
Walworth County
June 4, 1948

Lloyd L Jensen
County Surveyor
C.S.


1848

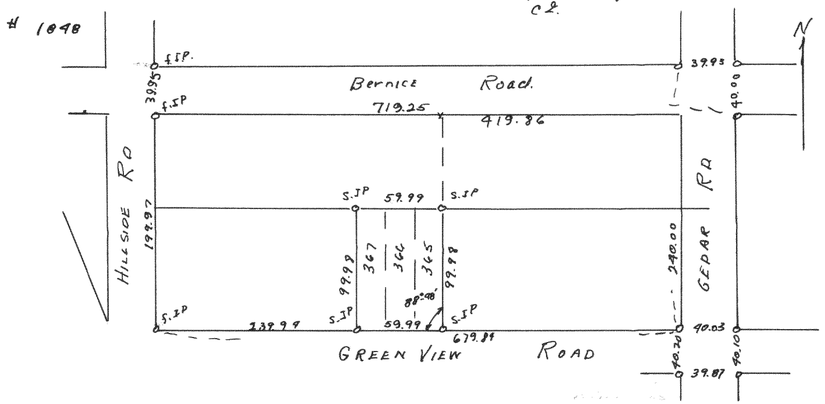

Plat of survey of Lots 365-367 Pell Lake Subdivision in TINRIBE
Walworth County
July 29. 1948

Lloyd L Jensen
County Surveyor
C.S.

1849

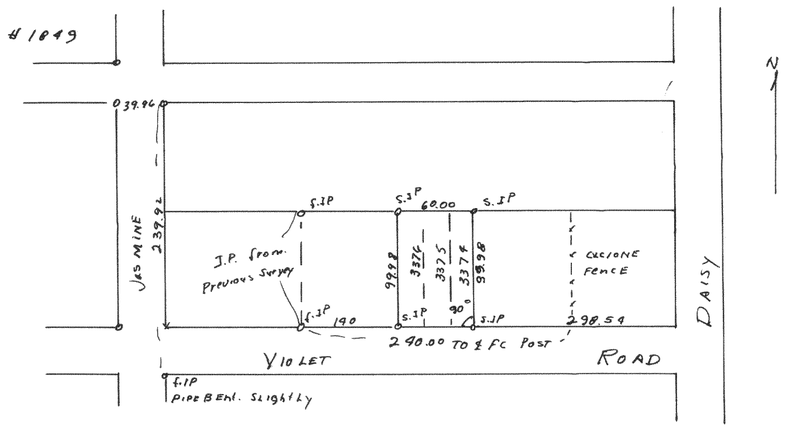

Plat of survey of lots 3374-3376 Section 3 Pell Lake Subdivision
in TINRIBE Walworth County
July 29. 1948

Lloyd L Jensen
County Surveyor.
C.S.