
343

1850

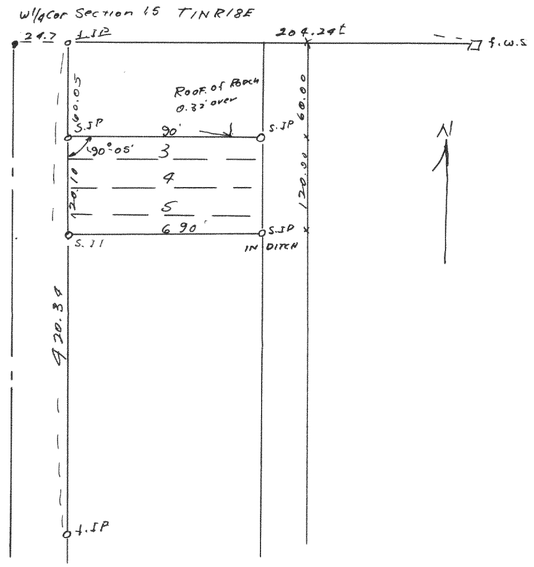


Plat of survey of lots 3-6 of Settlers Subdivision at Pell Lake located in SW 1/4 of Section 15 T1N R18E Walworth County.

Aug. 25, 1998

Lloyd L Jensen
County Surveyor
cs.

1851

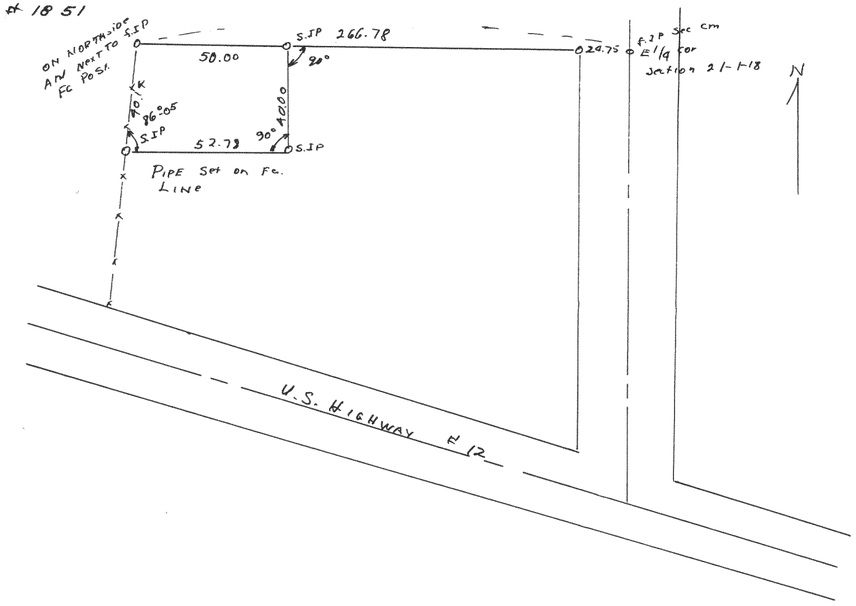

Plat of survey of parcel of land located in the SE 1/4 of Section 21 T1NR18E Walworth County

Sept. 1998

Lloyd L. Jensen
County Surveyor
cs.