
1852

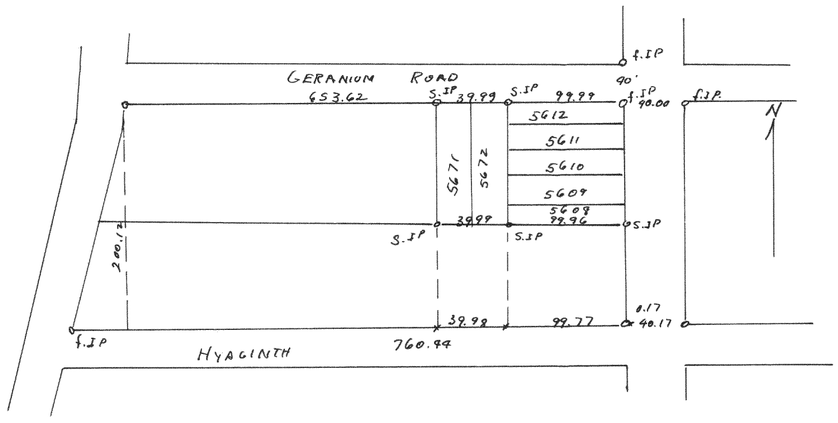


Plat of survey of lots 5608-5612 & 5671-5622 of Section 3 Pell Lake Subdivision in T1NR18E Walworth County

NOV 6. 1998

Lloyd L Jensen
County Surveyor.
cl

1853

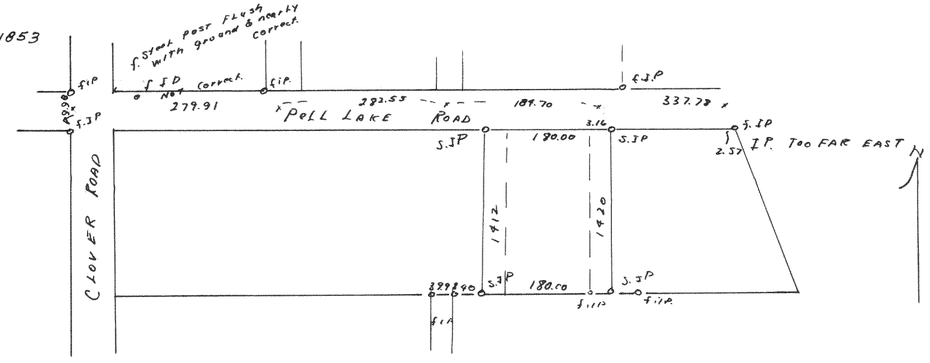


Plat of survey of lots 1912-1920 Section 1 of Pell Lake Subdivision in T1NR18E Walworth County

NOV 13, 1998

Lloyd L Jensen
County Surveyor.
cl

1854

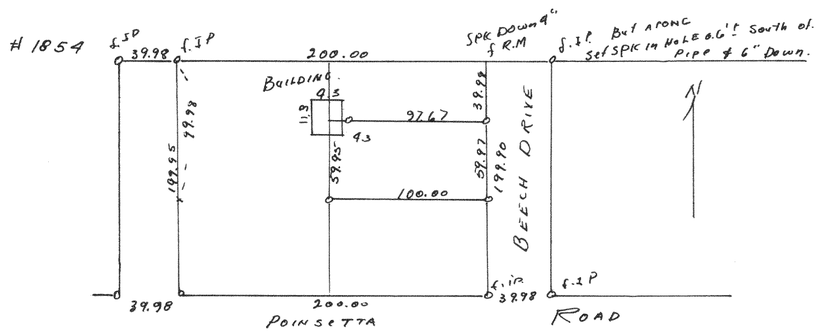


Plat of survey of lots 9322-9329 of Section 5 of Pell Lake Subdivision in T1NR18E Walworth County.

NOV 15, 1998

Lloyd L. Jensen
County Surveyor
cl.

1855

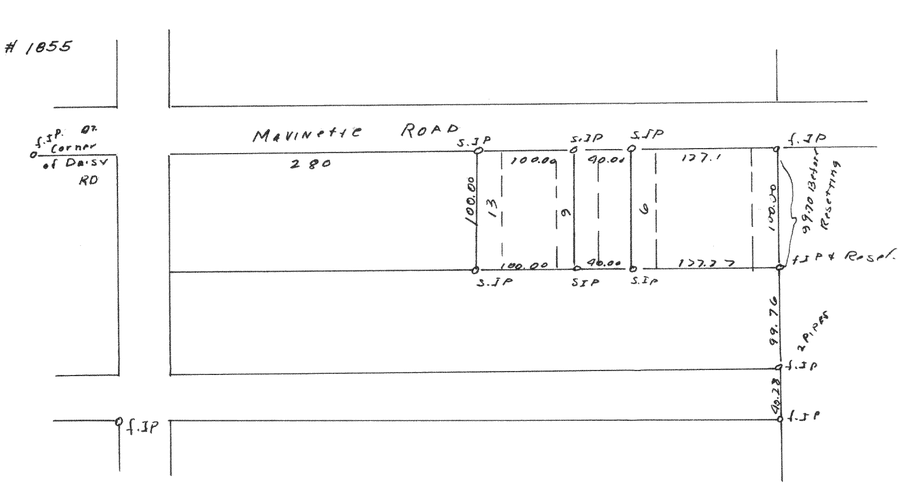

Plat of survey of lots 1-6, 9-13 of Pell Lake addition located in Section 1 T1N R18E Walworth County

NOV. 15, 1998

Lloyd L Jensen
County Surveyor
cl