

1859

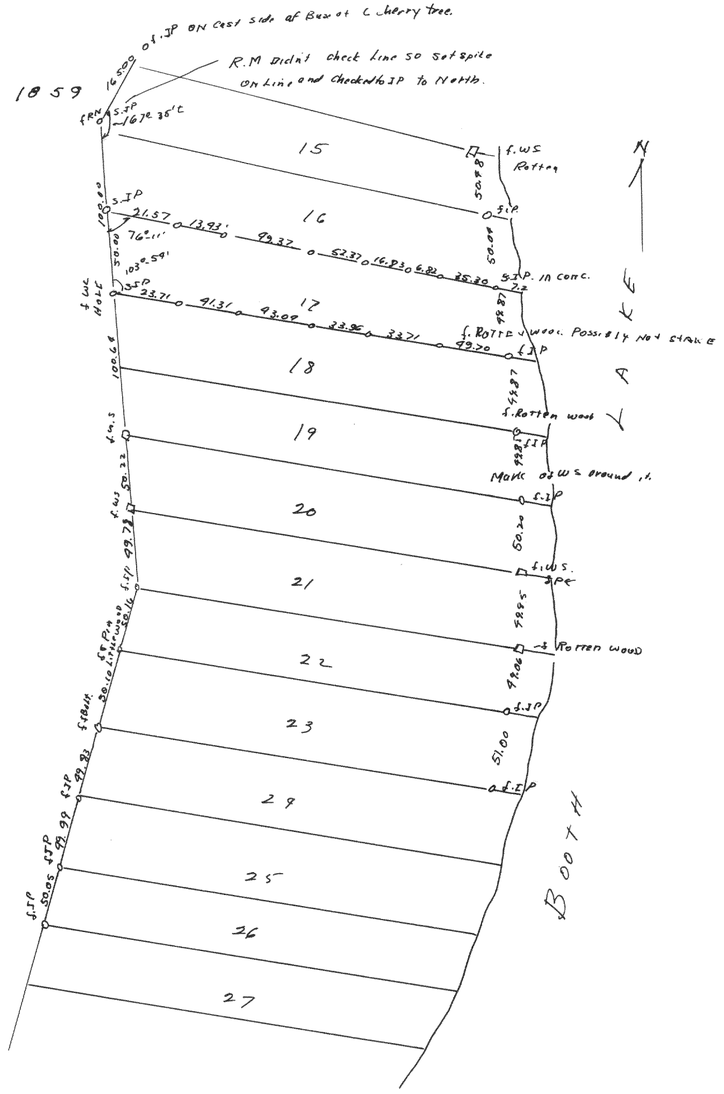

Plat of survey of Lot 17, Booth Lake Heights Subdivision located in Section ~~13~~ 20 & ~~24~~ T4NR17E Walworth County
July 19, 1998

Lloyd L Jensen
County Surveyor.
cl.

1860

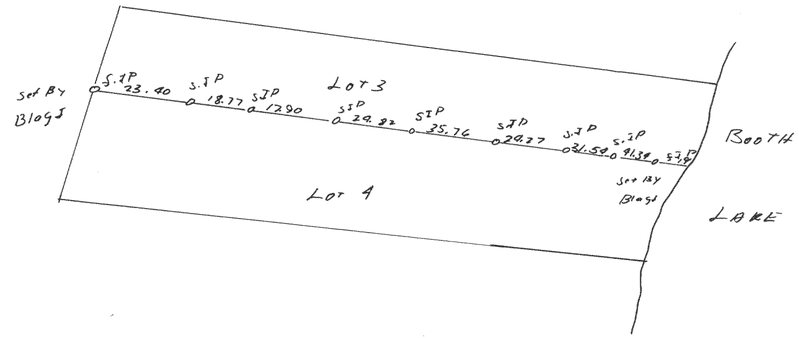

Plat of line y pipe set between Lots 3 & 4 y Booth Lake Heights Subdivision located in Section ~~13~~ 20 T4NR17E Walworth County
July 27, 1998

Lloyd L Jensen
County Surveyor.
cl.