
398

#1861

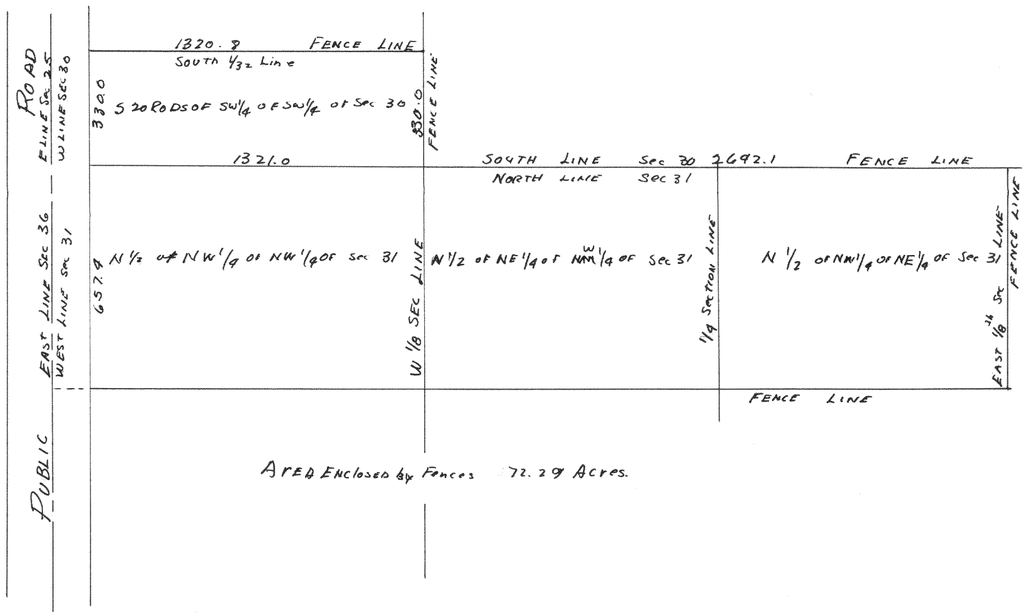


AREA ENCLOSED by Fences 72.29 Acres.

Plat of Survey of the present fence lines marking the property known as the Zimmer Farm located on Section 30 + 31 of T4NR17E Walworth County

April 1 1948

Lloyd L. Jensen
County Surveyor
S.D.

#1862

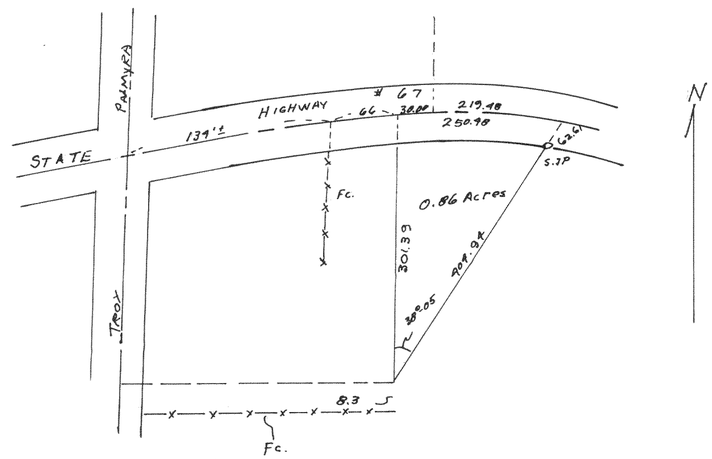

Plat of survey of a parcel of land located in the Northwest 1/4 of Section 6, T4NR17E Walworth County

Sept 16, 1948

Lloyd L. Jensen
County Surveyor
S.D.