

#1865

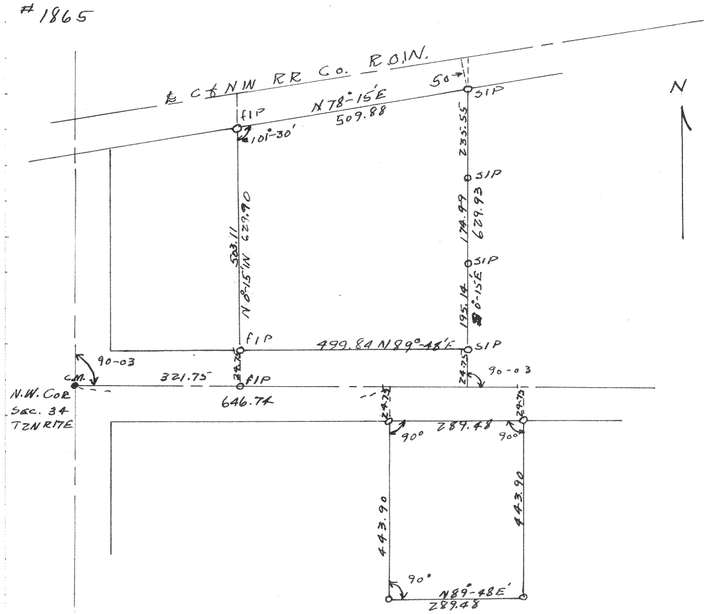

Plat of survey of a parcel of land located in the SW 1/4 of section 27 and another parcel in NW 1/4 of section 34 all in T2NR17E Walworth County
1948

Lloyd T. Jensen
Surv.

#1866

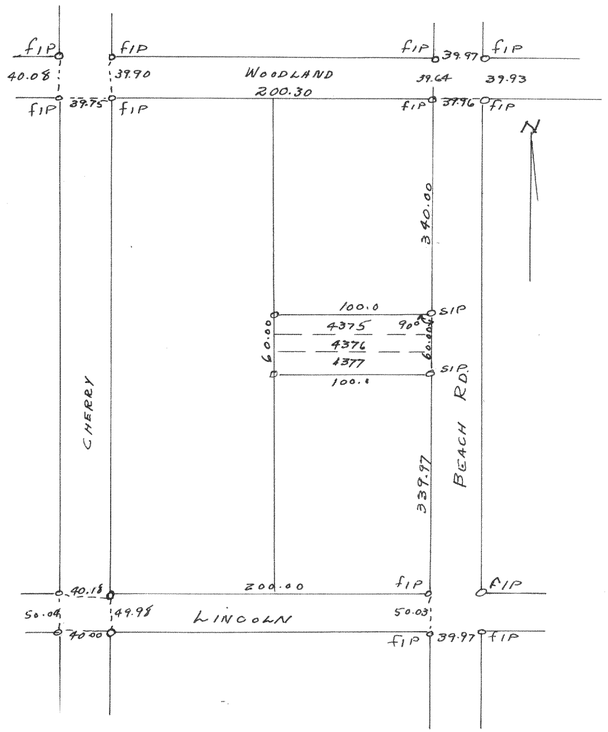

Plat of survey of lots 4375-4377 Lake Como Beach Subdivision in sections 21 & 22 T2NR17E Walworth County
July 8, 1948

Lloyd T. Jensen
Surv.