

1867

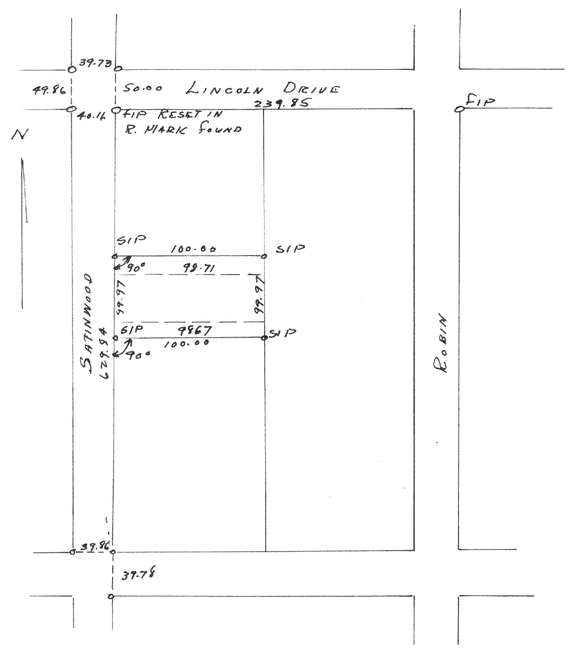

Plat of survey of lots 9867-9871 Lake Como Beach Subdivision located in Section 21 & 22 T2NR17E Walworth County.
July 17, 1948

Lloyd L. Jensen
Surv.

1868

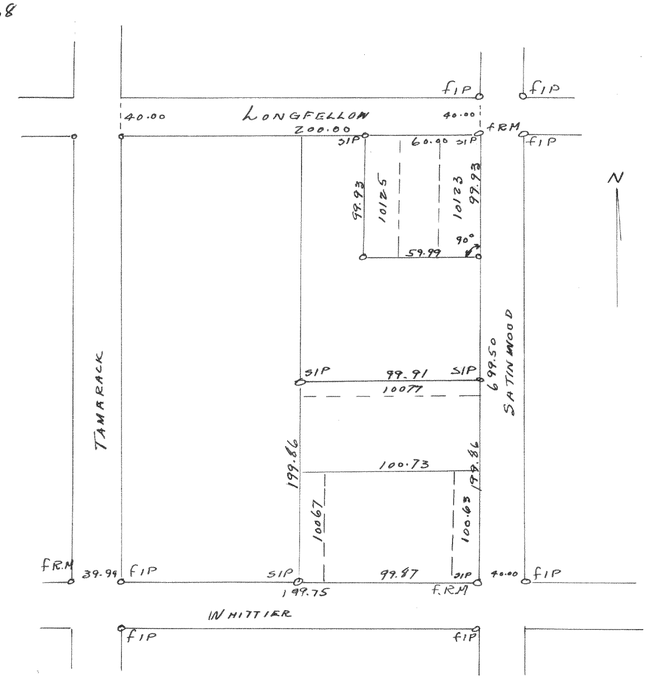

Plat of survey of lots 10063-10067, 10073-10077 & 10123-10125 in Lake Como Beach Subdivision in Sections 21 & 22, T2NR17E Walworth County.
Aug 17, 1948

Lloyd L. Jensen
Surv.