

#1869

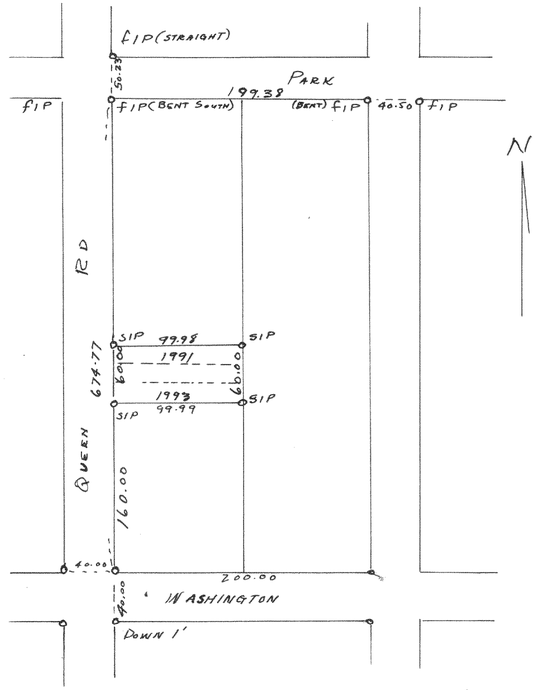

Plat of survey of lots 1991-1993, Lake Como Beach Subdivision Sections 21 & 22, T2N R17E in Walworth County
Aug 17, 1948
Floyd L. Jensen
Cty. Sv.

#1870

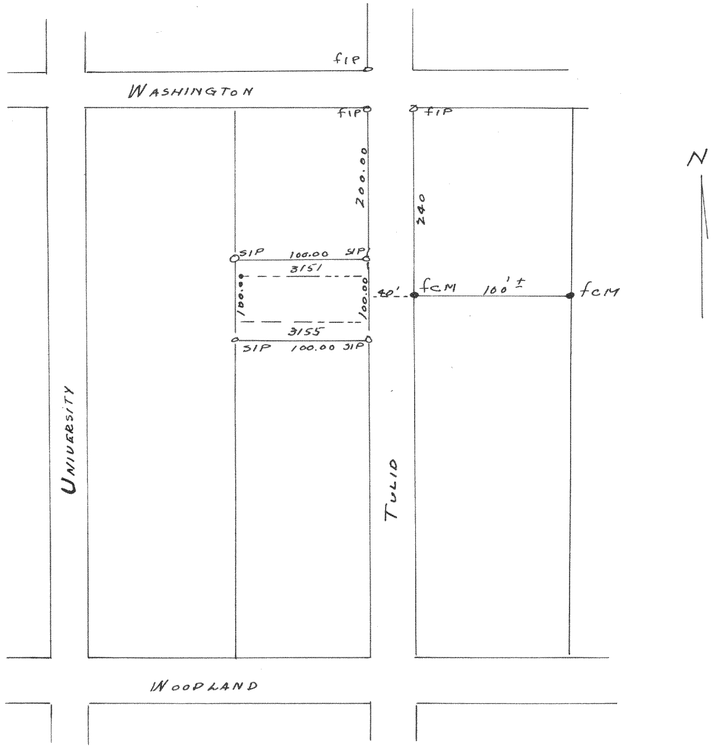

Plat of survey of lots 3151 - 3155, Lake Como Beach Subdivision located in Sections 21 & 22, T2N R17E Walworth County
Aug 18, 1948
Floyd L. Jensen
Cty. Sv.