1874

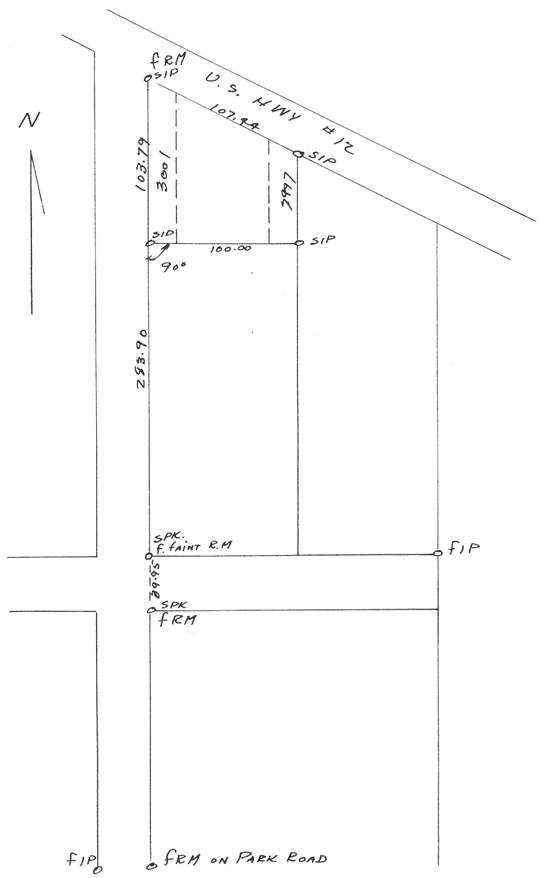

Plat of survey of lots 2997-3001 Lake Como Beach Subdivision located in Sections 21 & 22 T2NR17E Walworth County
Aug 18, 1948
Lloyd F. Jensen
CWS.

1875

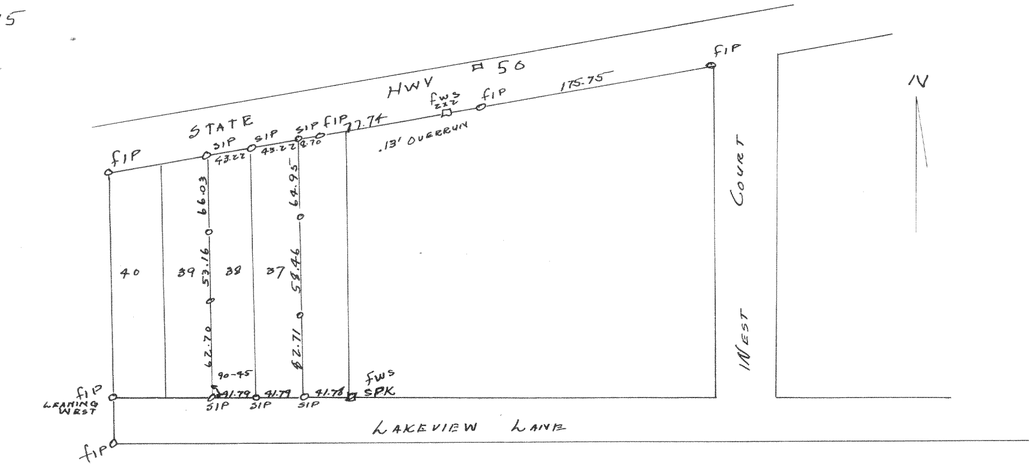

Plat of survey of lots 37 & 38 in Lake Geneva Knoll Subdivision located in Section 32, T2NR17E Walworth County.
Aug 24, 1948
Lloyd F. Jensen
CWS.