

356

1876

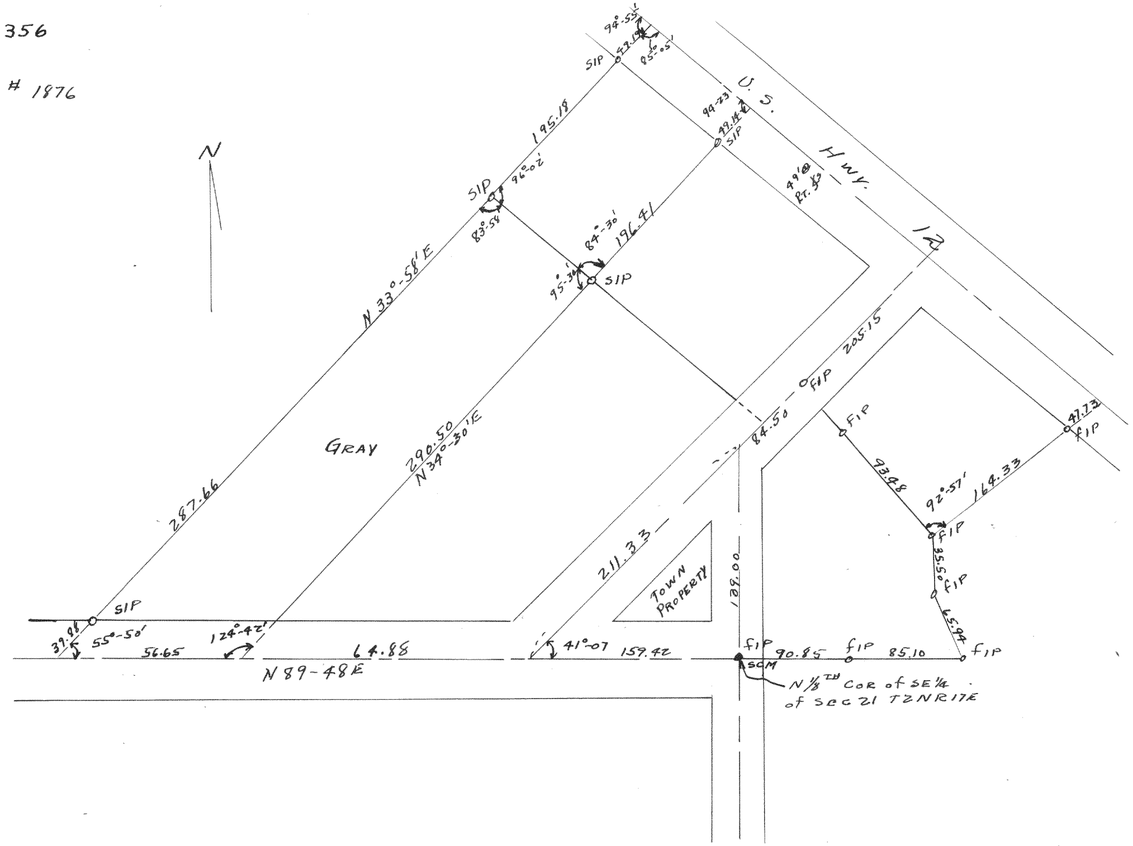

Plat of survey of parcels of land located in the SE¼ of Section 21 T2N R17E Walworth County
Sept 8. 1948
Floyd I. Jensen
cuby

1877

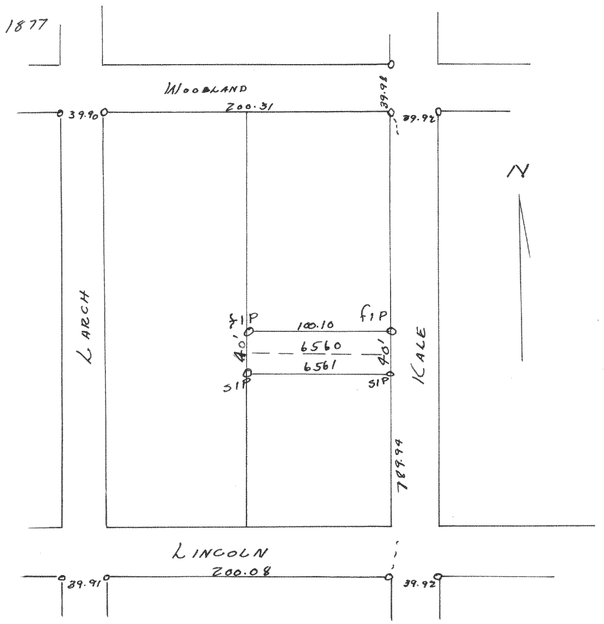

Plat of Survey of lots 6560-6561 Lake Como Beach Subdivision located in Sections 21 and 22 T2N R17E Walworth County
Sept 12, 1948
Floyd I. Jensen
cuby