

1878

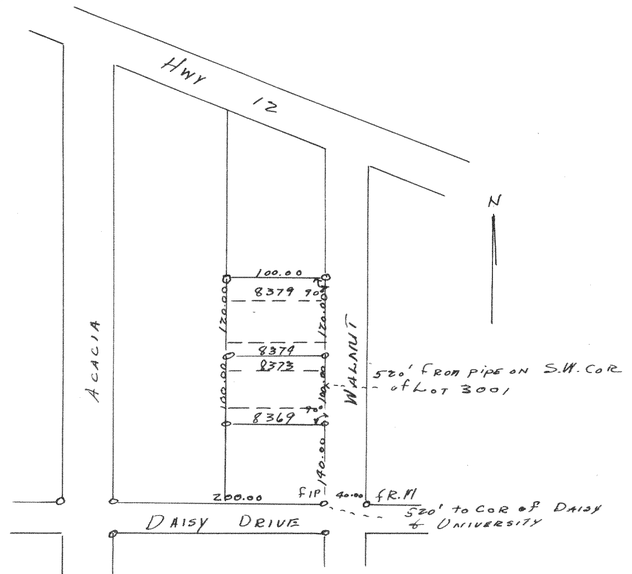

Plat of Survey of lots 8369-8379, Lake Como Beach Subdivision located in sections 21 & 22 T2N R17E Walworth County
Oct 8, 1948

Lloyd L. Jensen


1879

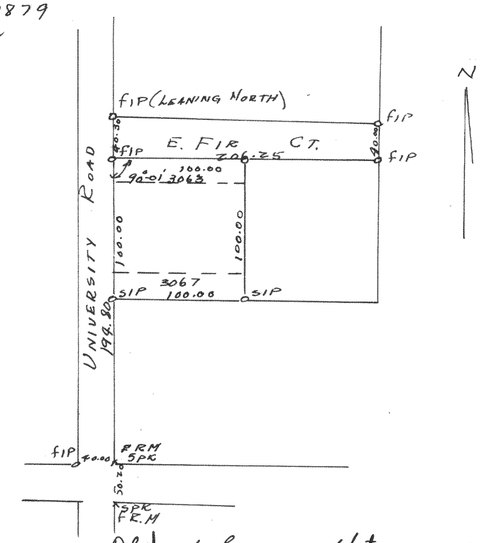

Plat of Survey of lots 3063-3067 Lake Como Beach Subdivision located in sections 21 & 22 T2N R17E Walworth County
Oct 8, 1948

Lloyd L. Jensen.
CWS


1880

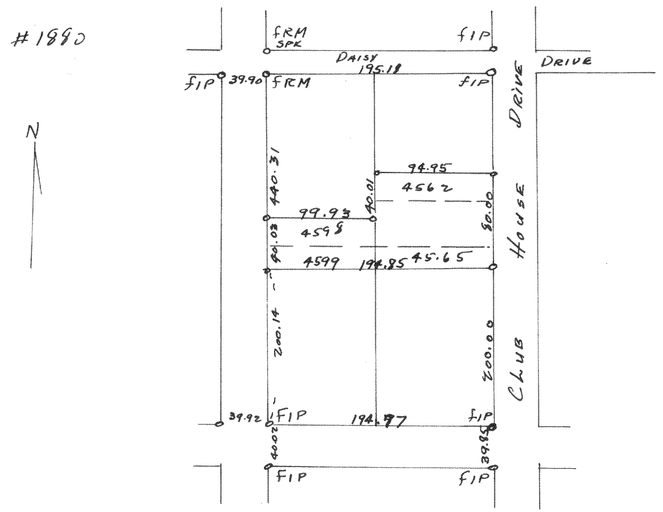

Plat of Survey of lots 4562-5 & 4598-9 Lake Como Beach Subdivision located in sections 21 & 22 T2N R17E Walworth County
Oct. 14, 1948

Lloyd L. Jensen

1881

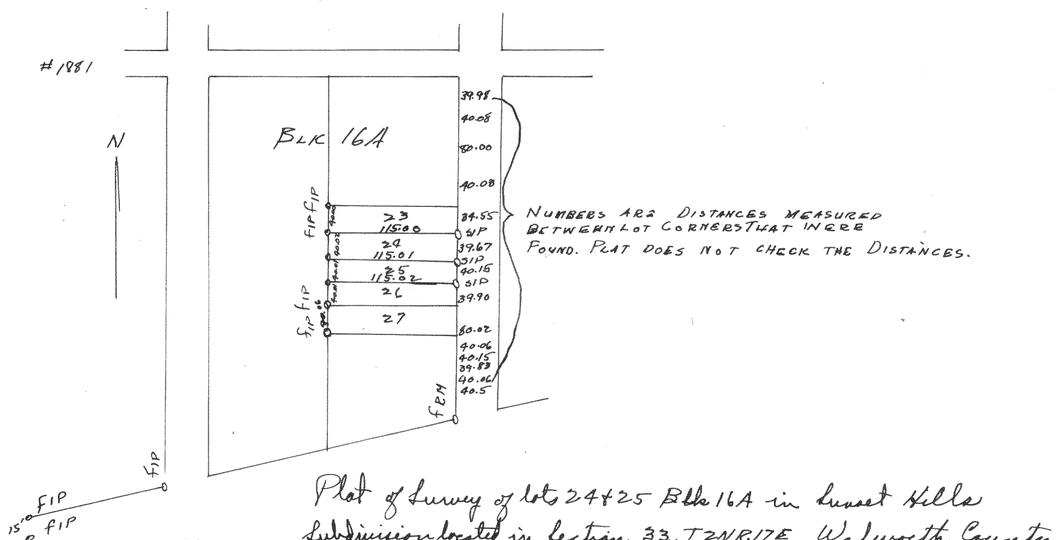

Plat of Survey of lots 24 & 25 Blk 16A in Sunset Hills Subdivision located in section 33, T2N R17E, Walworth County
Oct 16, 1948

Lloyd L. Jensen
CWLS