

1882

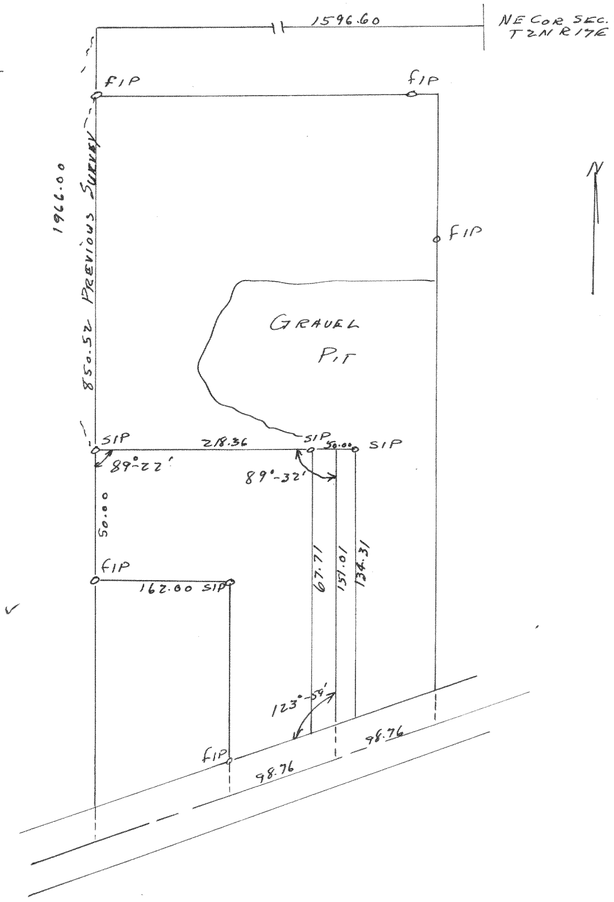

Plat of Survey of a parcel of land located in the NE. 1/4 of Section 25, T2N R17E, Walworth County
Dec 7, 1948

Lloyd L. Jensen
CWS.

1883

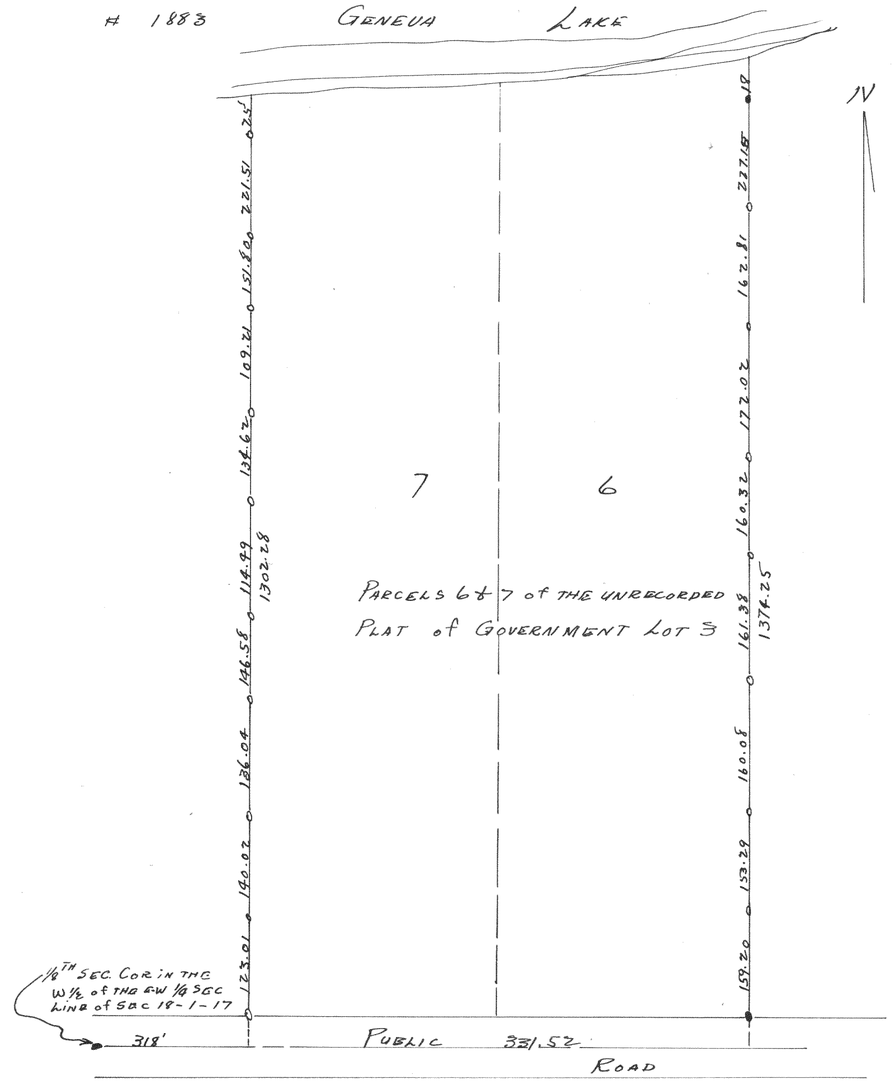

Plat of Survey of East & West lines of that part of the Boy Scout Camp lying north of the public highway located in Section 18 T1N R17E Walworth County
Nov. 1948

Lloyd L. Jensen
CWS