

#1984

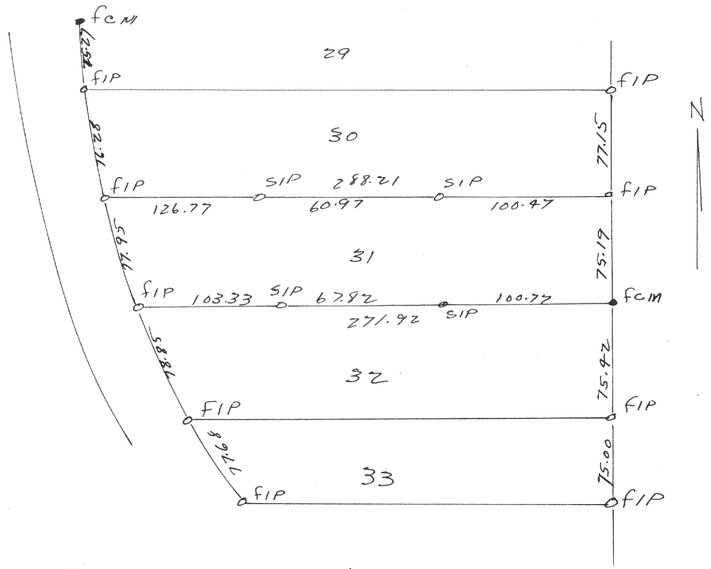

Plat of Survey of lot 31 in "The Dunkes" 1st addition located in Section 9, T1N R17E
Oct. 1948

Floyd L. Jensen
Surv

#1985

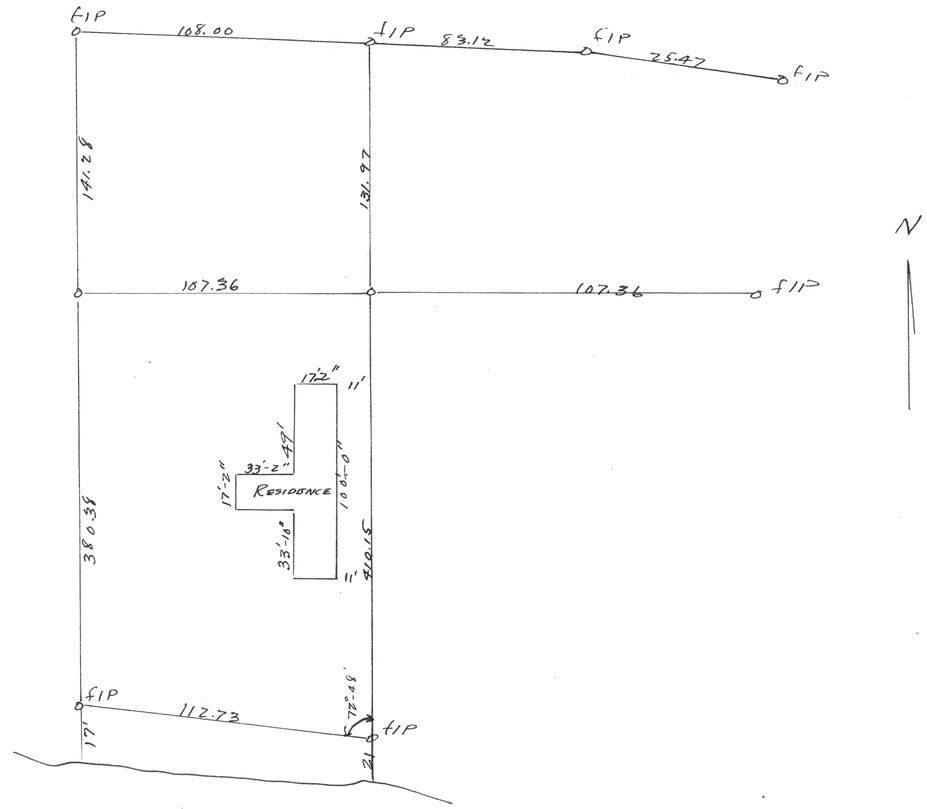

Plat of Survey of lot 3 in S.B Chopins Subdivision
located in section 5 T1N R17E Walworth County
Aug 1948

Floyd L. Jensen
Surv