

1887

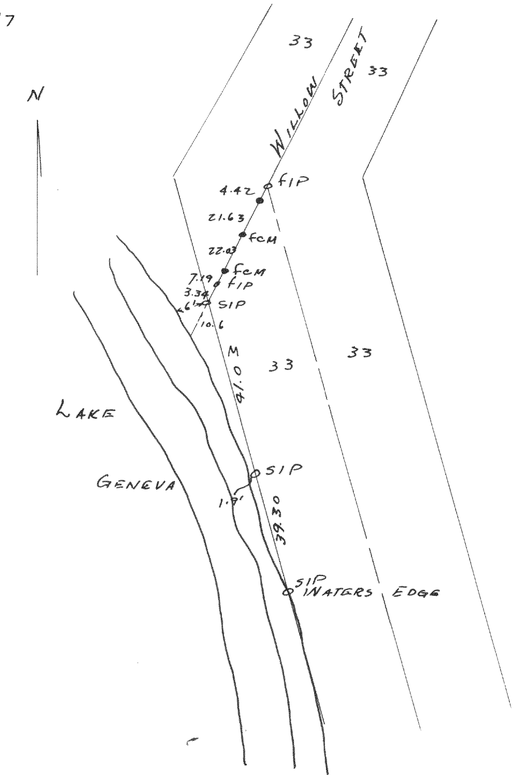

Plat of Survey of the land between the waters edge of Lake Geneva and the edge of the R.O.W of the Public Road on the Motag Farm. Section 1 T1NR17E Walworth County
Nov. 1948
Lloyd L. Jensen

1888

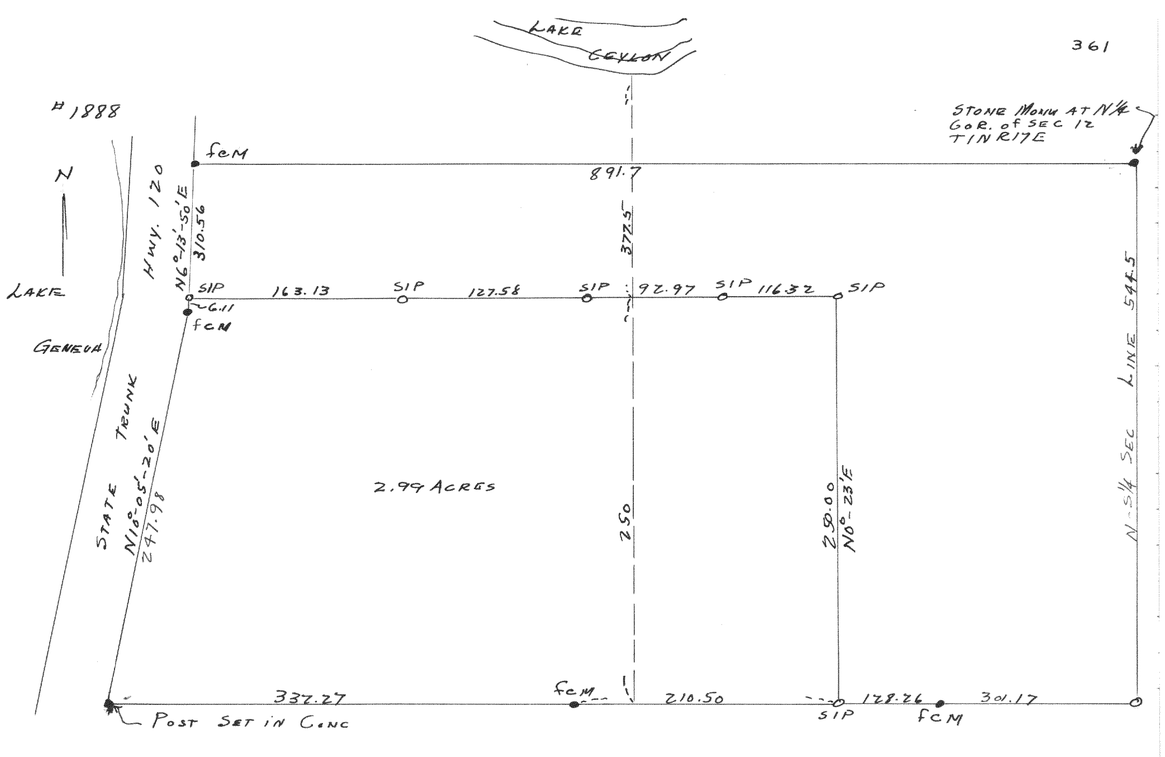

Plat of Survey of a parcel of land located in the NW ¼ of Section 12, T1NR17E, Walworth County
Sept 24, 1948
Lloyd L. Jensen
Cur L.