
#1889

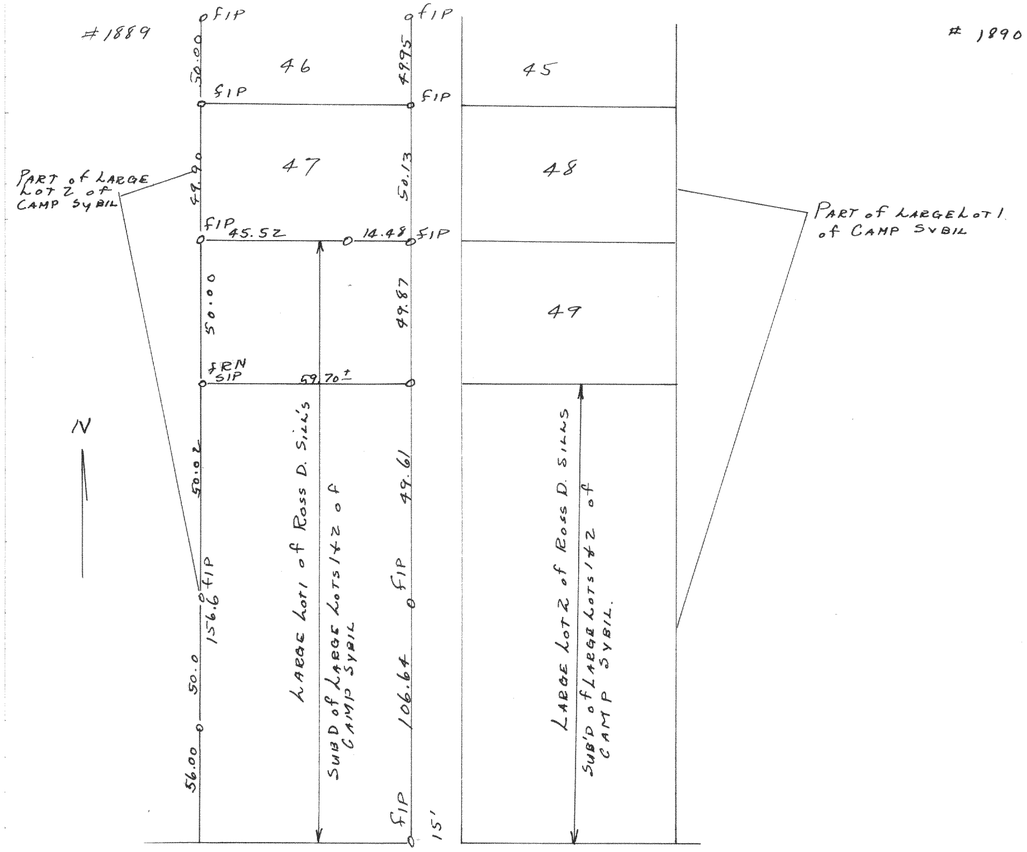


Plat of a survey of part of large lot 1 of Ross D Sills Subd of large lots 1 & 2 of Camp Sybil located in the NE fractional 1/4 of Section 18, T1N R17E Walworth County

July 29, 1948

Floyd L. Jensen
CLS

#1890

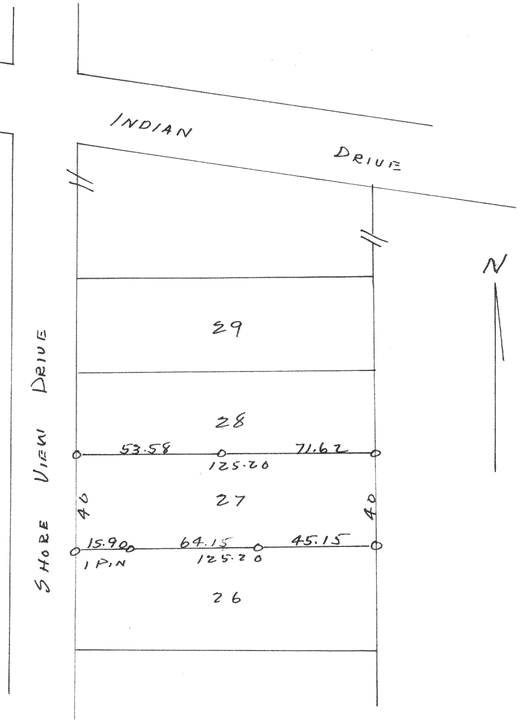

Plat of Survey of Lot 27 Blk "F" in Circo Beach Subd. located in Sec. 5, T1N R17E

Sept 1948

Floyd L. Jensen
CLS