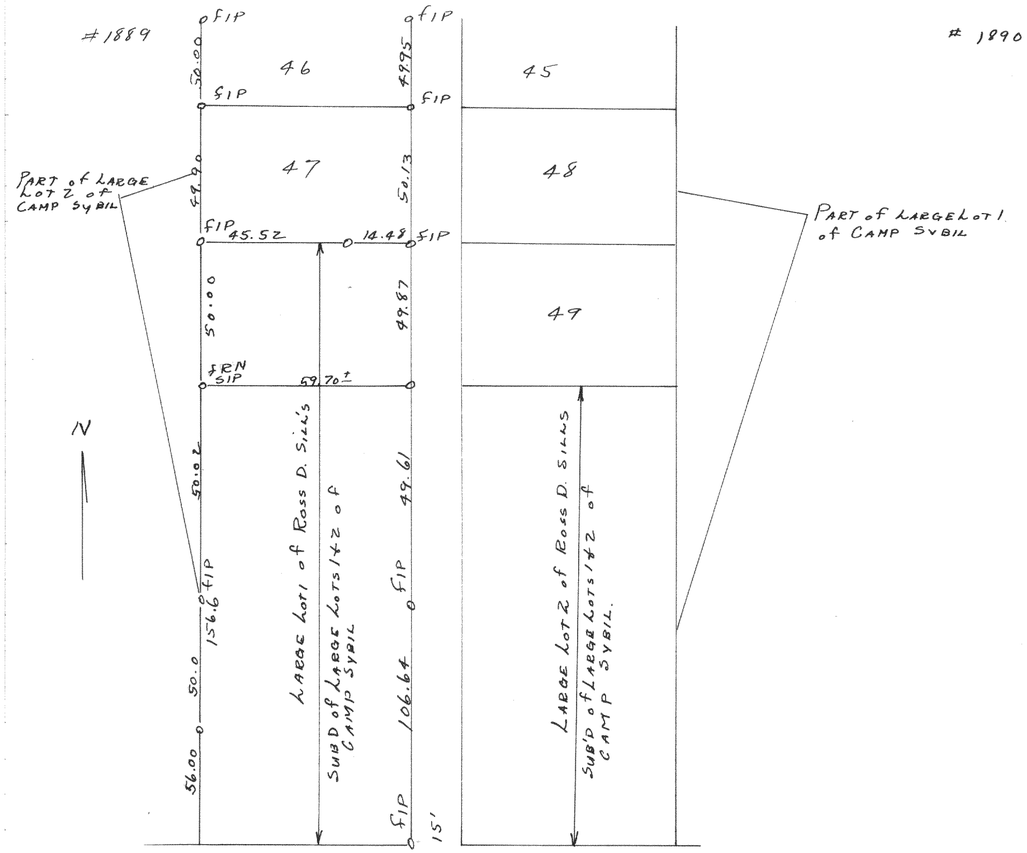

Plat of a survey of part of large lot 1 of Ross D Sills Subd of large lots 1 & 2 of Camp Sybil located in the NE fractional 1/4 of Section 18, T1N R17E Walworth County
July 29, 1948
Floyd L. Jensen
CWS

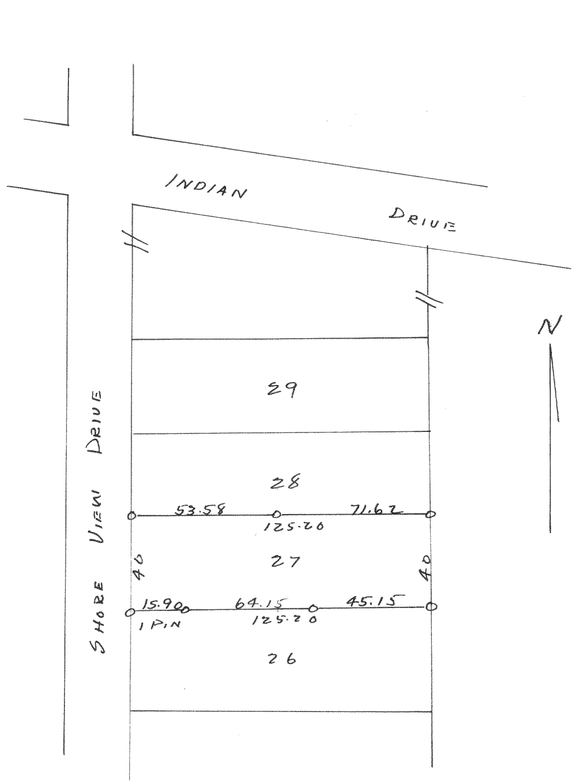

Plat of Survey of Lot 27 Blk "F" in Cisco Beach Subd. located in Sec. 5, T1N R17E
Sept 1948
Floyd L. Jensen
CWS