
1905

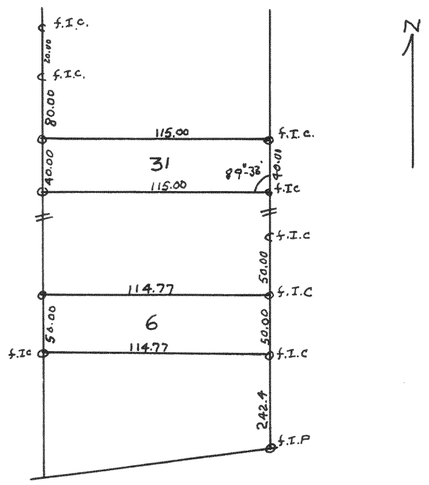


Plat of survey of lots 6 & 31 Block 14 in Sunset Hills Subdivision located in Section 33, T1N R17E

July 8, 1948

Lloyd S Jensen
County Surveyor

1906

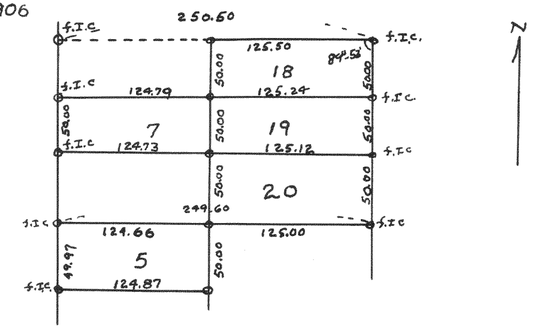


Plat of survey of lots 18, 19, & 20 of Block 24 Sunset Hills Subdivision located in Section 33, T2N R17E

July 1948

Lloyd S Jensen
County Surveyor

1907

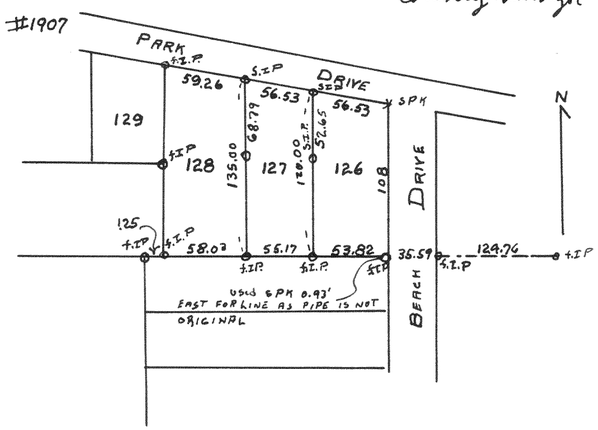


Plat of survey of lot 127 Lake Geneva Beach Subdivision located in Section 11, T1N R17E Walworth County Wisc.

Oct 19, 1948

Lloyd S Jensen
County Surveyor

1908

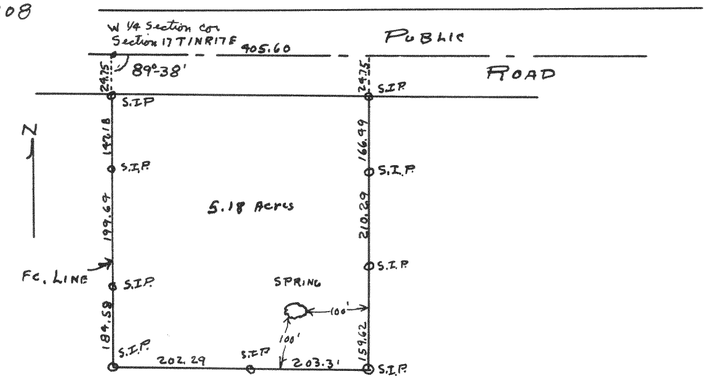

Plat of survey of parcel of land located in the SW 1/4 of Section 17 T1N R17E of Walworth County Wisconsin

December 24 1948

Lloyd S Jensen
County Surveyor