

1913

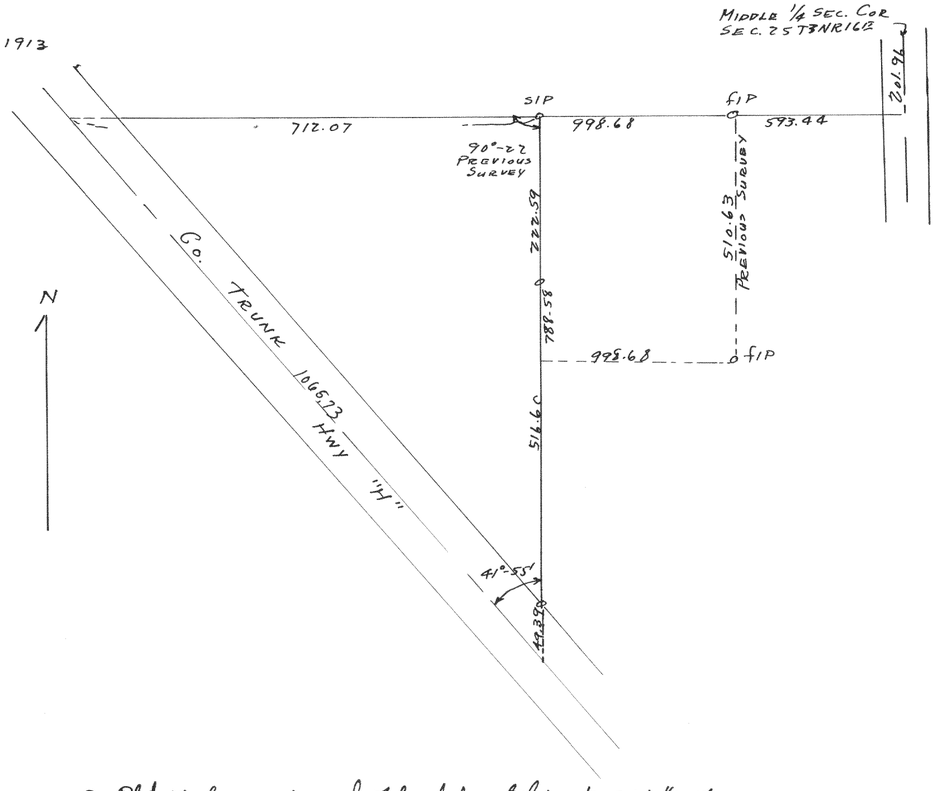

● Plat of survey of parcel of land located in the S.W 1/4 of Section 25, T3NR16E Walworth County
July 1948 Lloyd L. Jensen Civil.

1914

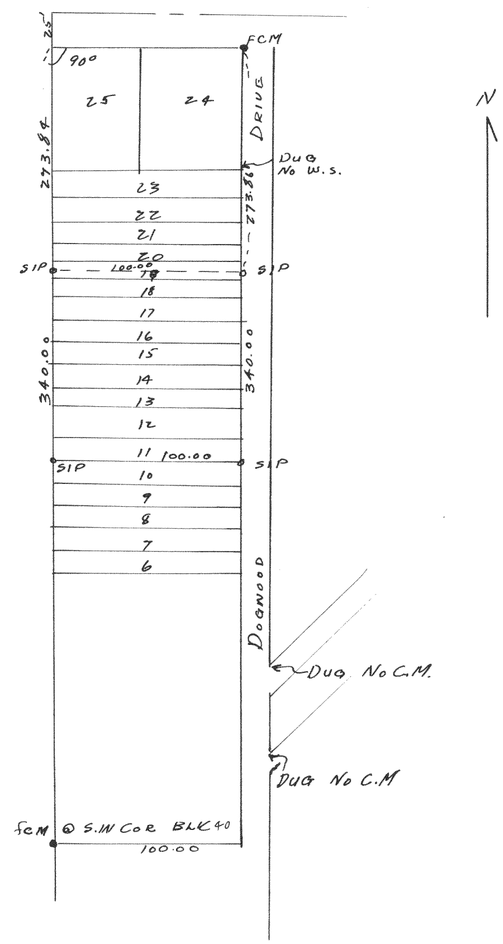

Plat of Survey of Lots 11-18 & the S. 1/2 of Lot 19 Interlaken Subd in Section 11, T3NR16E
July 28, 1948 Lloyd L. Jensen Civil.