
# 1915

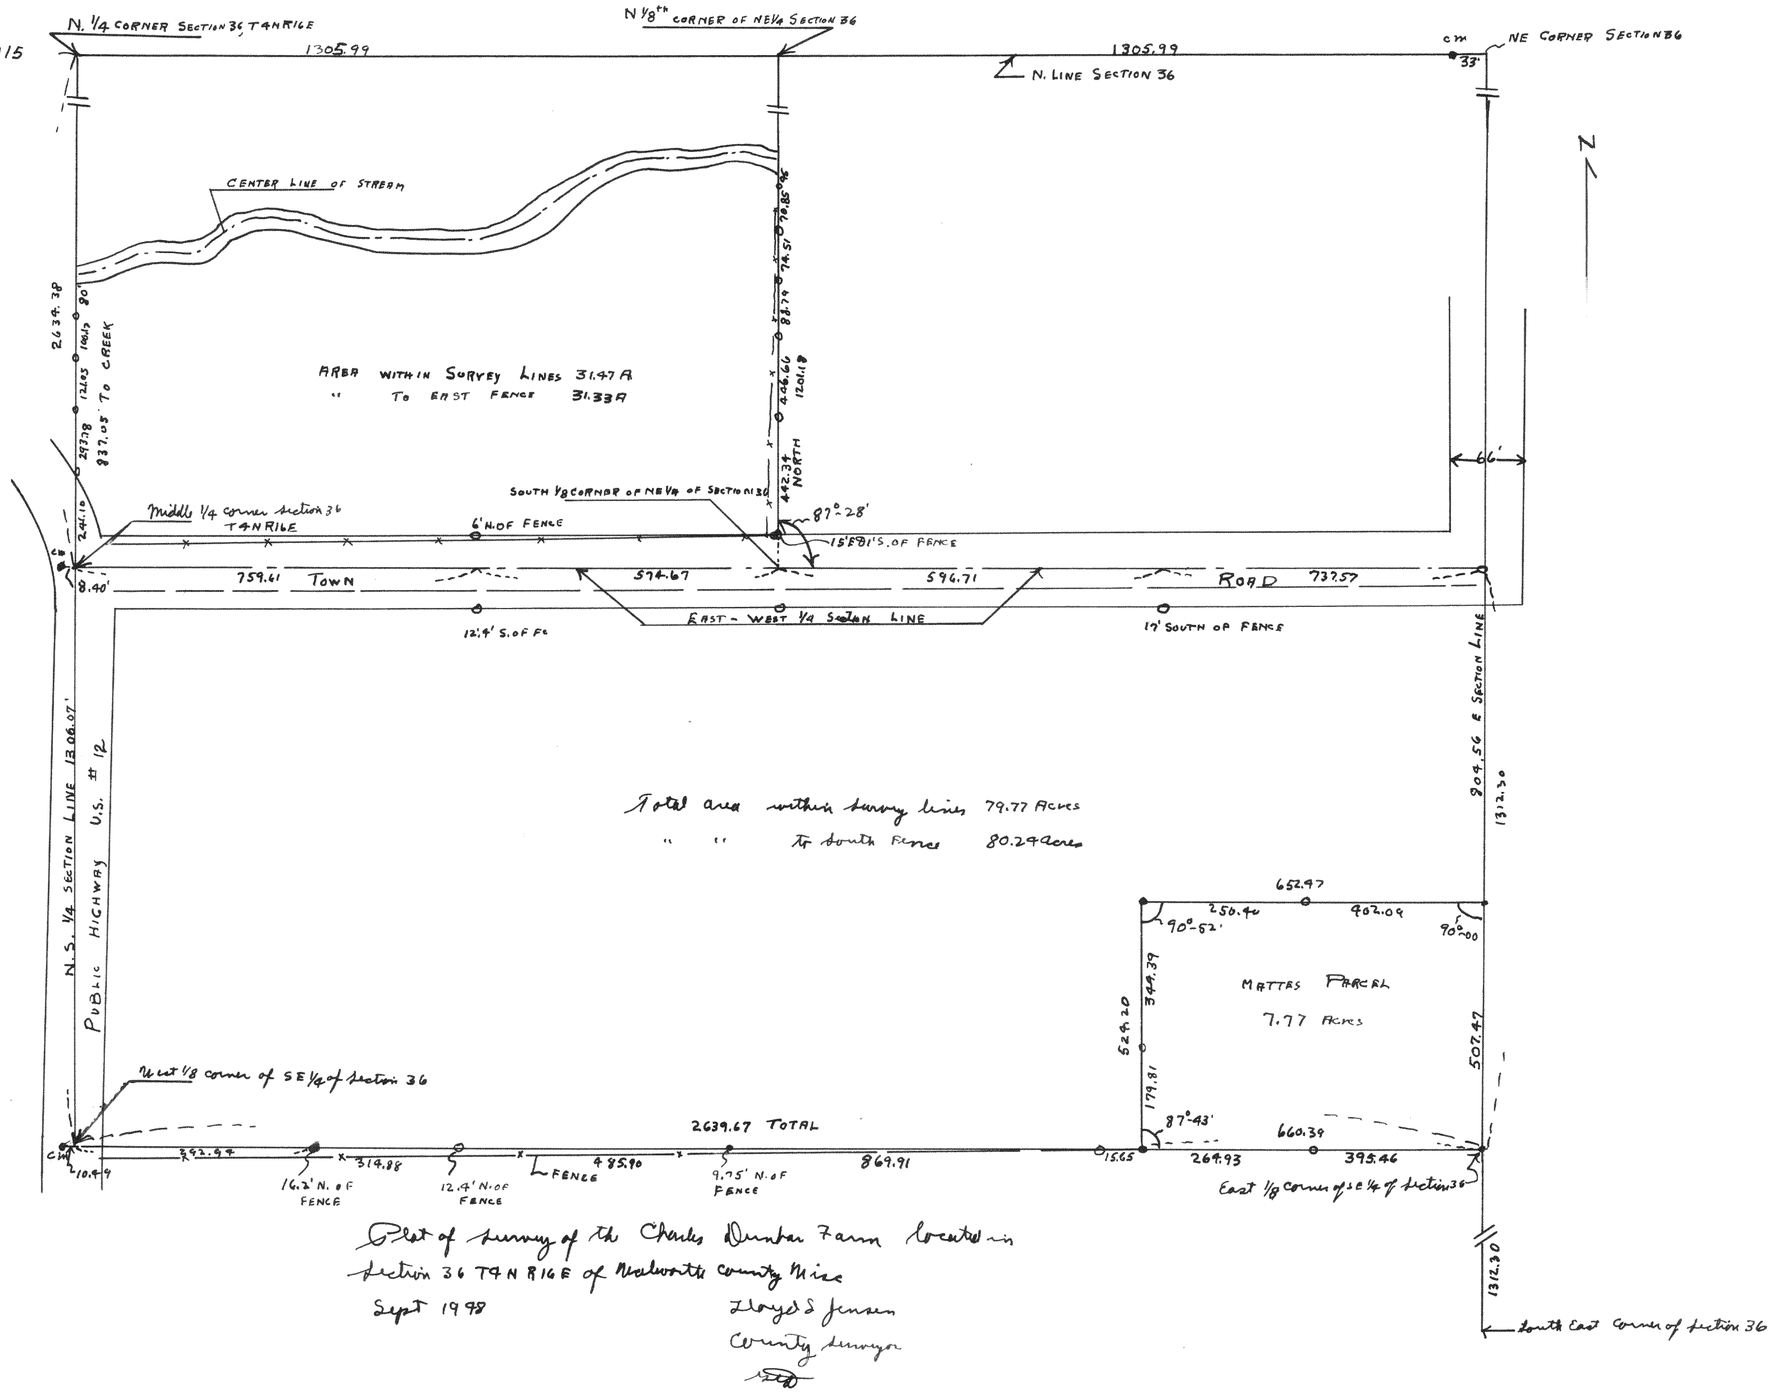



Lloyd S Jensen
County Surveyor