
372


1916

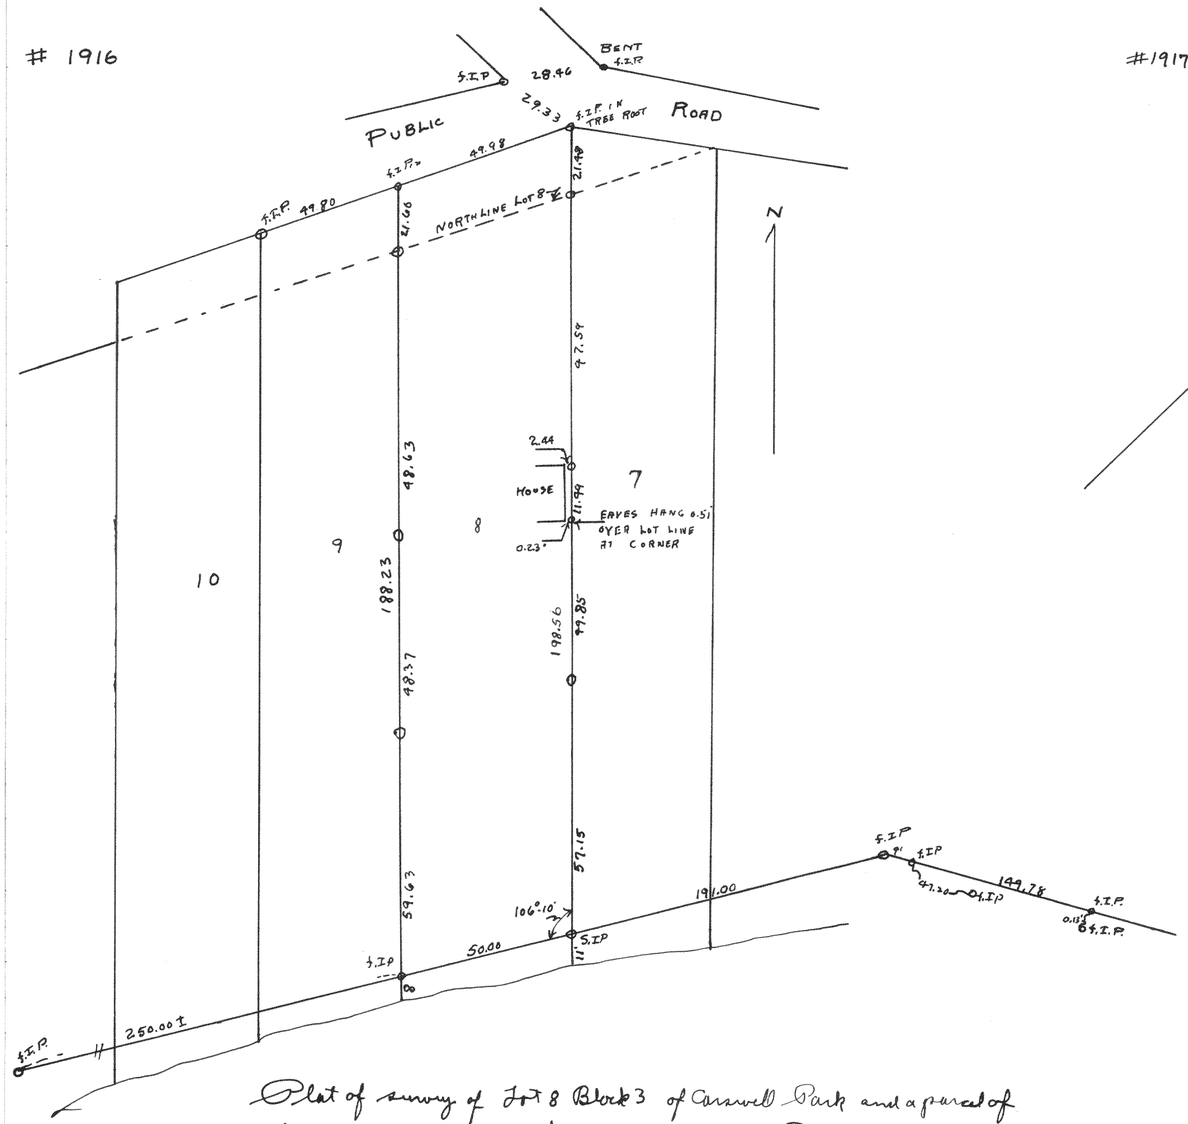

Plat of survey of Lot 8 Block 3 of Carswell Park and a parcel of land on the north end of lot 8 extending to the Public road located in Section 35 T 9 N R 16 E Walworth County Wisconsin
Oct 1998

Lloyd S Jensen
County Surveyor

#1917

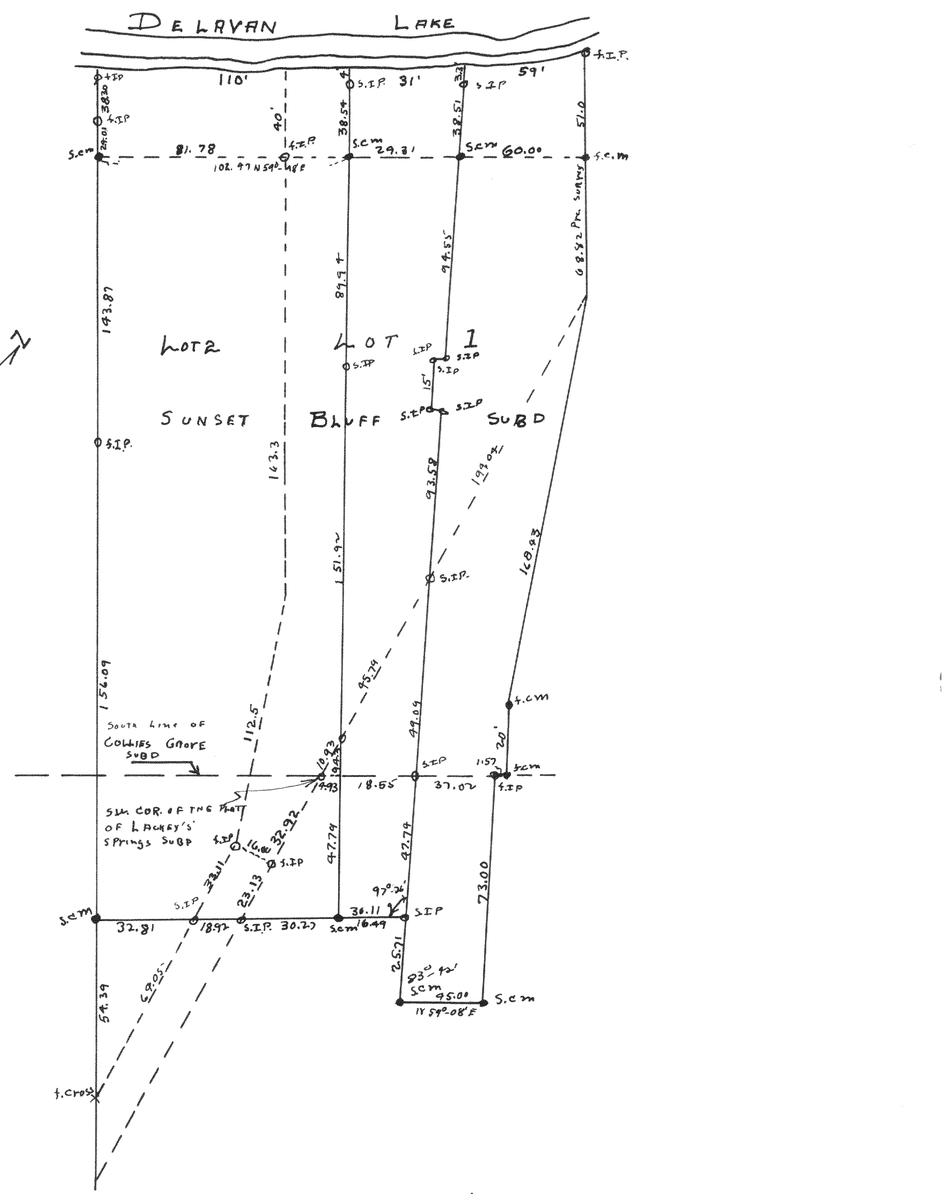

Plat of survey of parts of 3 subdivisions, located in the N ½ of Fractional Section 33 T 2 N R 16 E of Walworth County Wisconsin
May 1998

Lloyd S Jensen
County Surveyor