1918

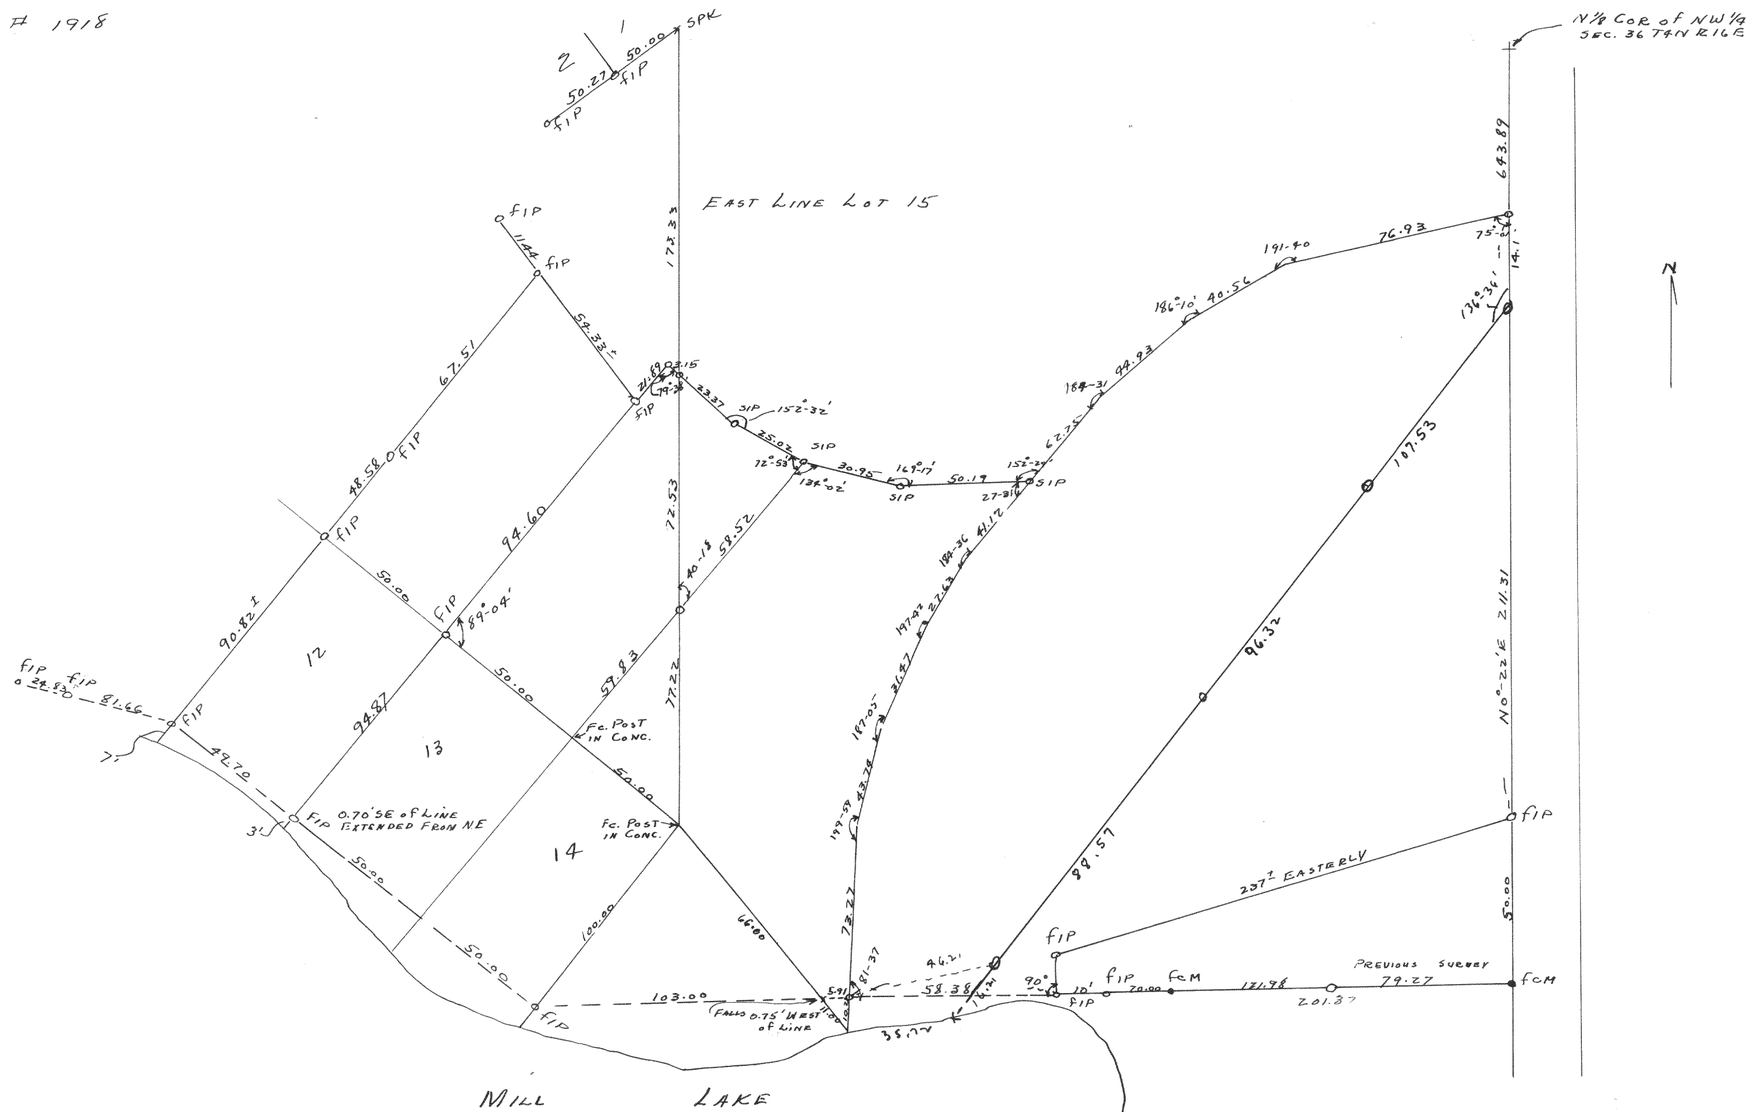

Plat of Survey of Part of lot 15 of Pleasant Point Subdivision and land located east and land joining lot 15 located in N.W 1/4 of Section 36 T4N R16E Walworth County

Oct. 26, 1948

Lloyd L. Jensen.
Cwly