

#1925

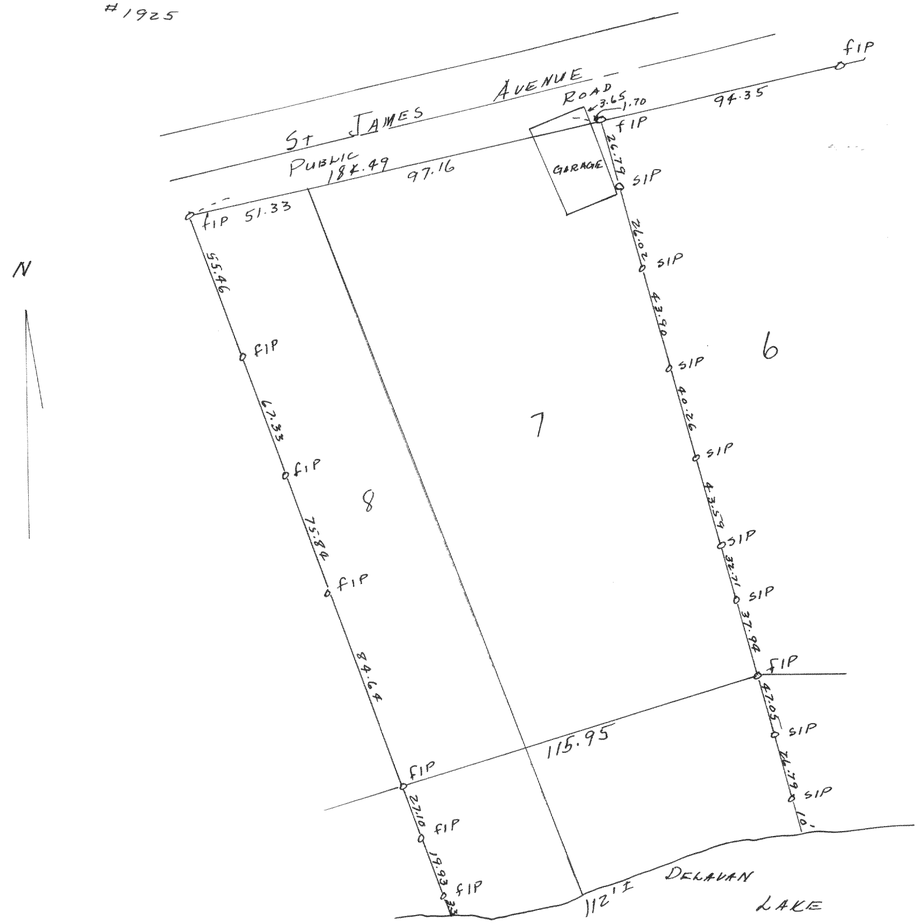

Plat of survey of lots 7&8 in St. Mary's Subdivision located in section 28 T2N R16E Walworth County
Sept. 1948

Lloyd L. Jensen

#1926

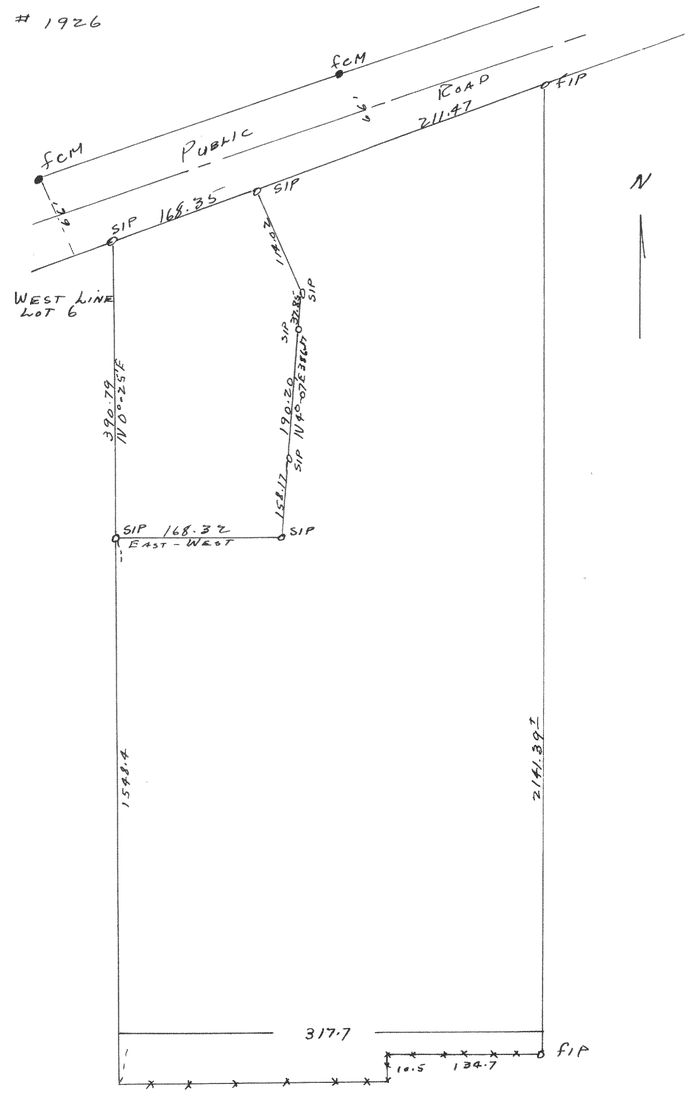

Plat of survey of parts of lot 6 & W½ lot 5 in The Subdivision of the S.E fractional ¼ of section 28 and the N.E fractional ¼ of Section 33 T2N R16E
Dec 1948

Lloyd L. Jensen
C.E.