
378


1927

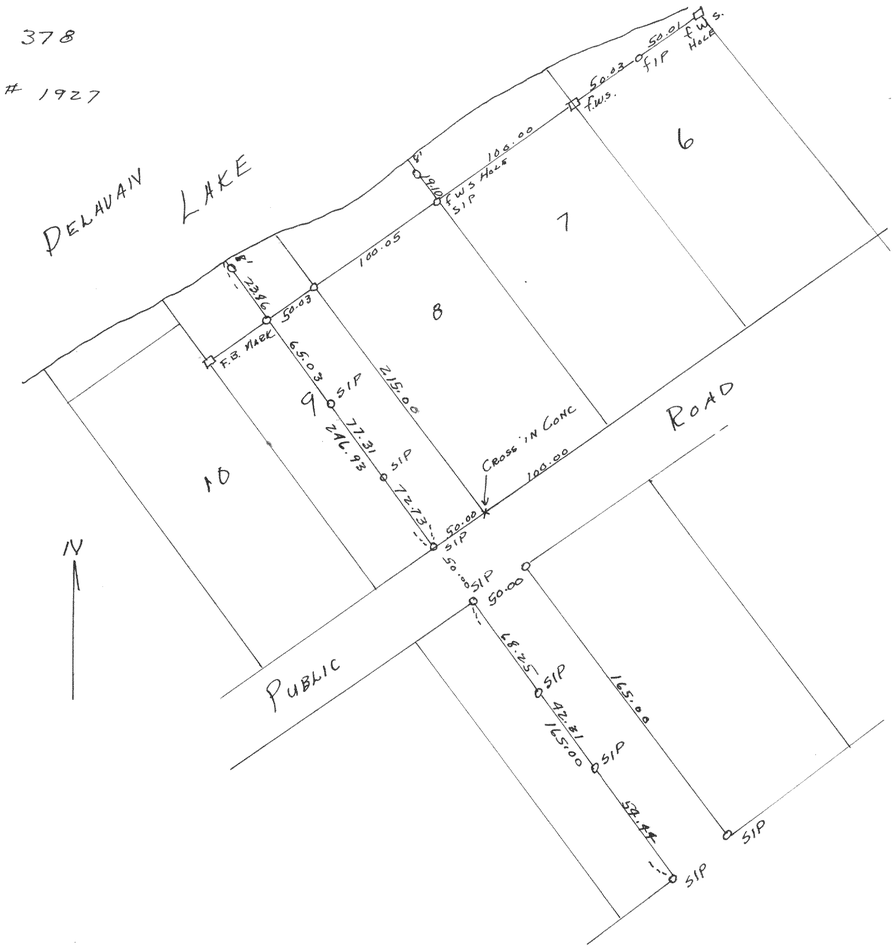

Plat of Survey of the N. ½ of Lot 9 in Harrington's Sub'd
and parcels of unplatted land located in Section 27, T2NR16E Walworth County
May 1948

Lloyd T. Jensen
C.W.S.

1928

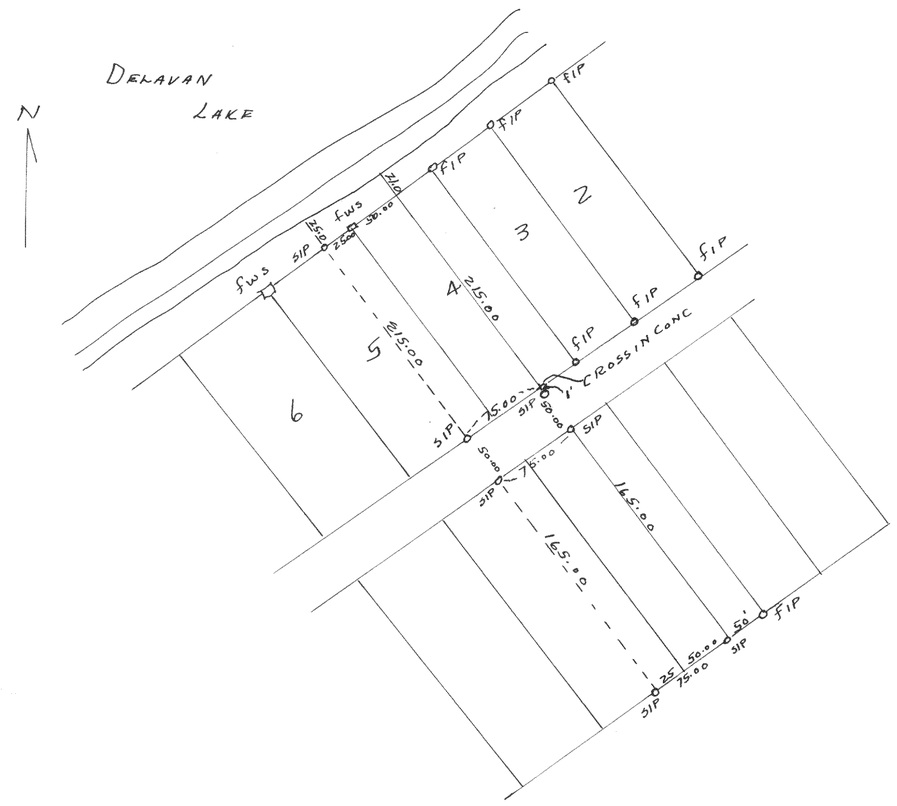

Plat of Survey of the N.E 25' of Lot 5 and the southwesterly ½ of Lot 4
Harrington's Subdivision Section 27, T2N R16E Walworth County
July 1948

Lloyd T. Jensen
C.W.S.