
380


#1930

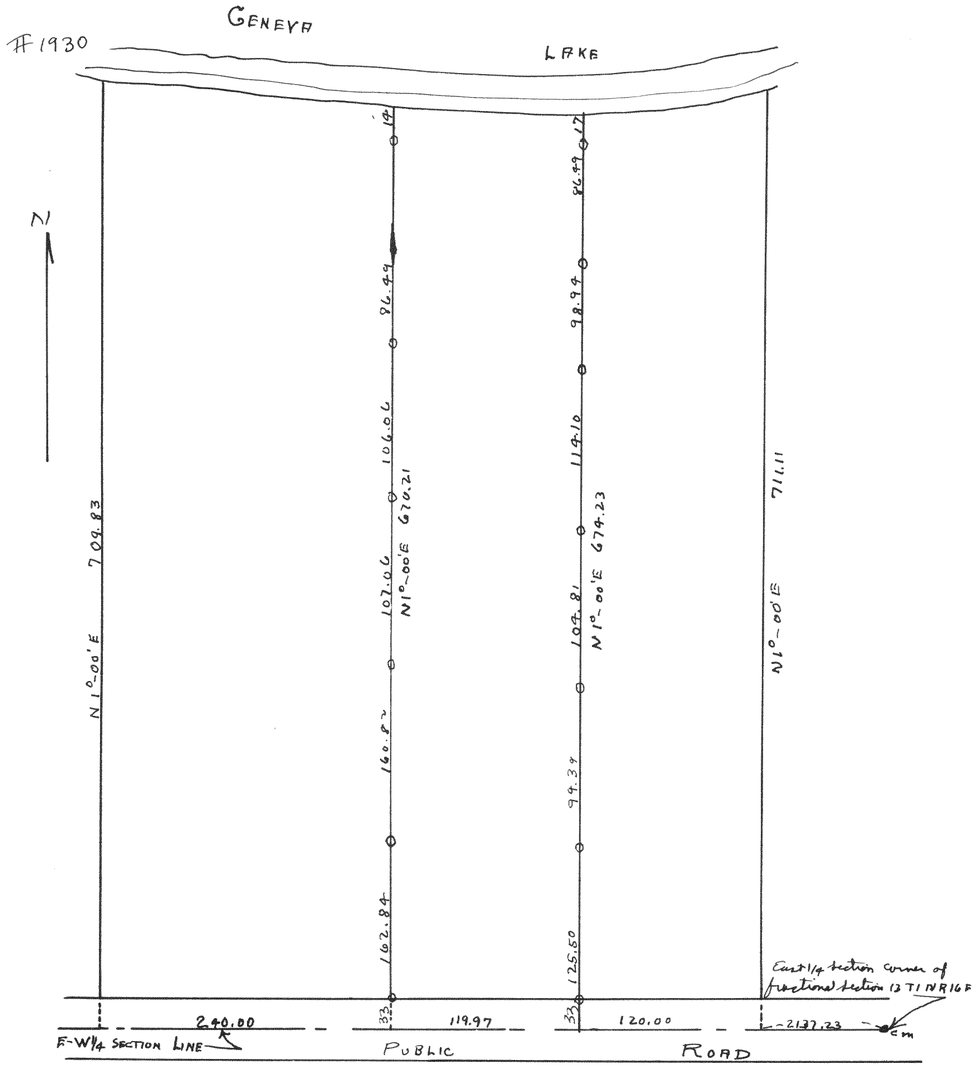

Plat of survey of land located in the N 1/2 of Fractional Section 13 T1N R16E of Walworth County Wisconsin
February 1998

Lloyd L Jensen
County Surveyor

#1931

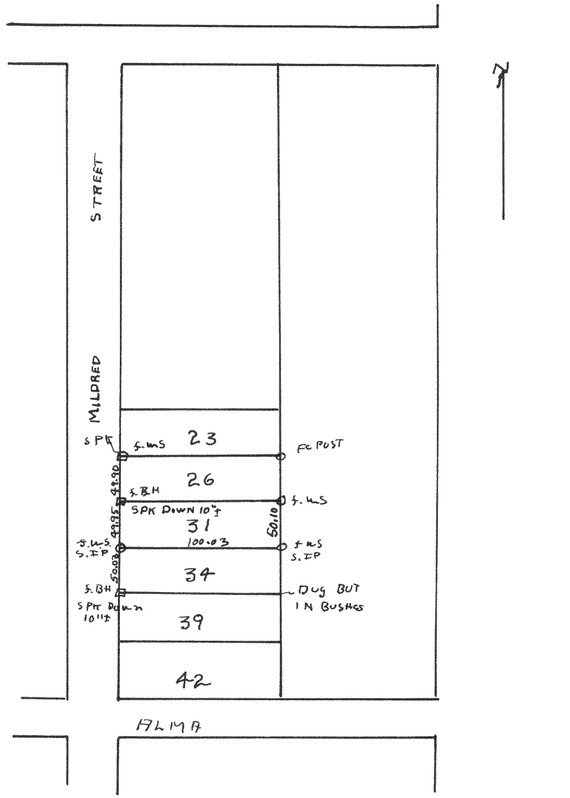

Plat of survey of the south line of Lot 31 Hillcrest Subdivision located in Section 5 T1N R16E of Walworth County Wisconsin
Aug 19 1998

Lloyd L Jensen
County Surveyor