

1939

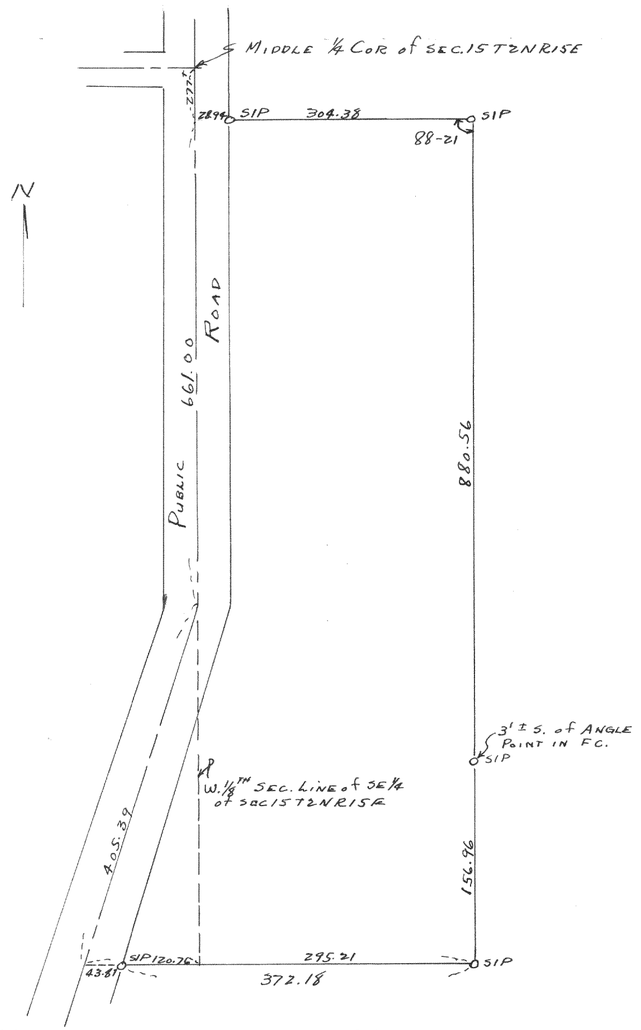

Plat of survey of a parcel of land located in the S ½ of section 15 T2N R15E Walworth County
Aug 30, 1948
Lloyd L Jensen
CWS

1940

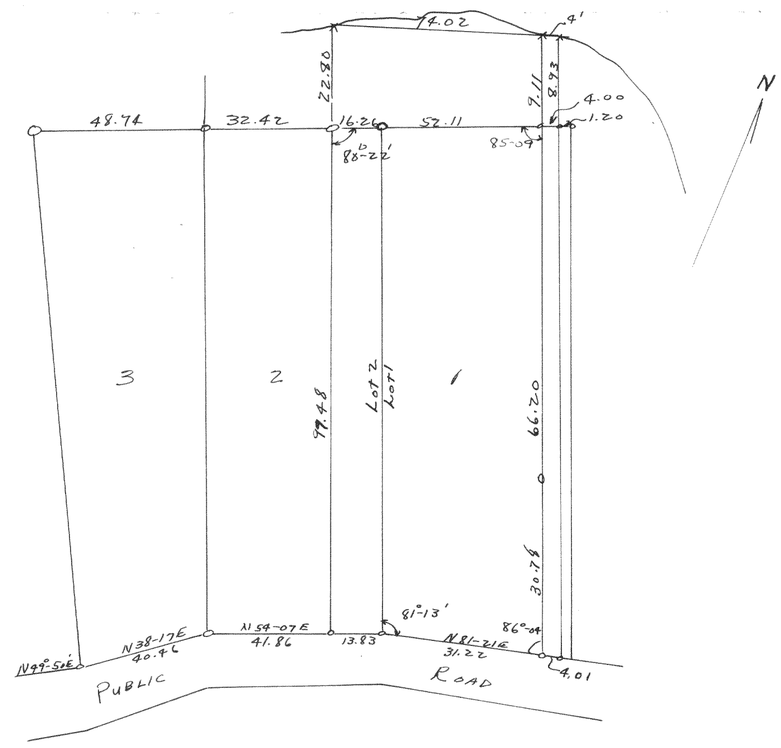

Plat of survey of parts of lots 1 & 2 Green Island Subd. Fairdale Lakes in S.E ¼ Section 26 T4N R16E Walworth County
May 14, 1948
Lloyd L. Jensen
CWS