

1945

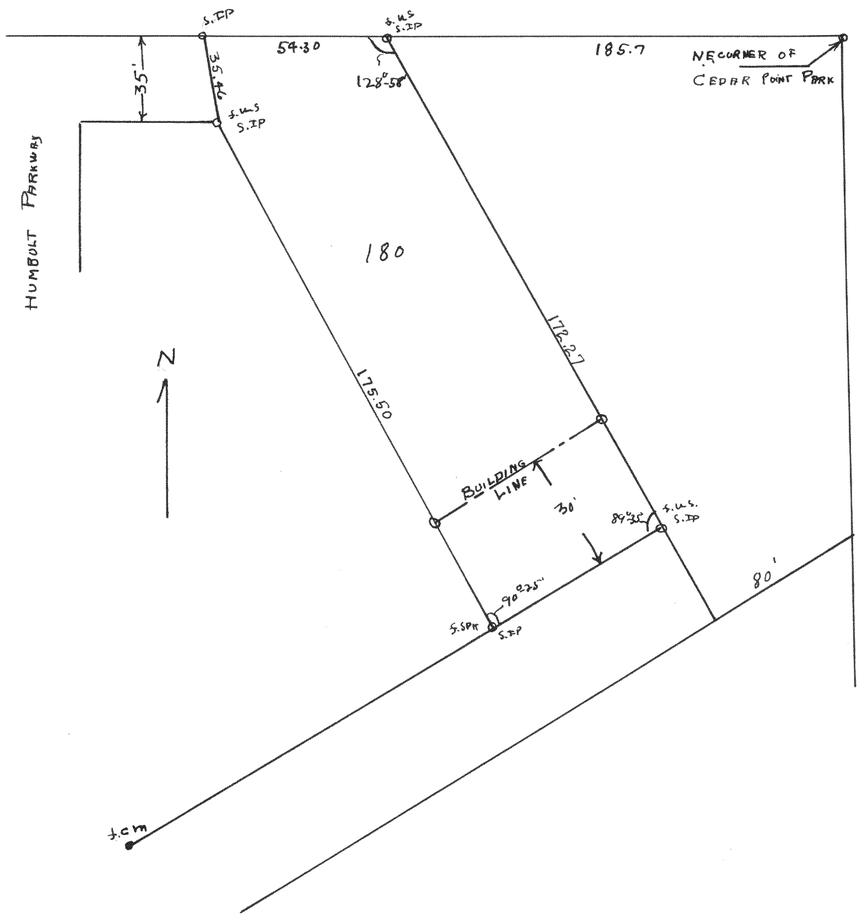

Plat of survey of Lot 180 Cedar Point Park Original Plat in the Village of Williams Bay
November 18, 1998

Lloyd S Jensen
County Surveyor

1946

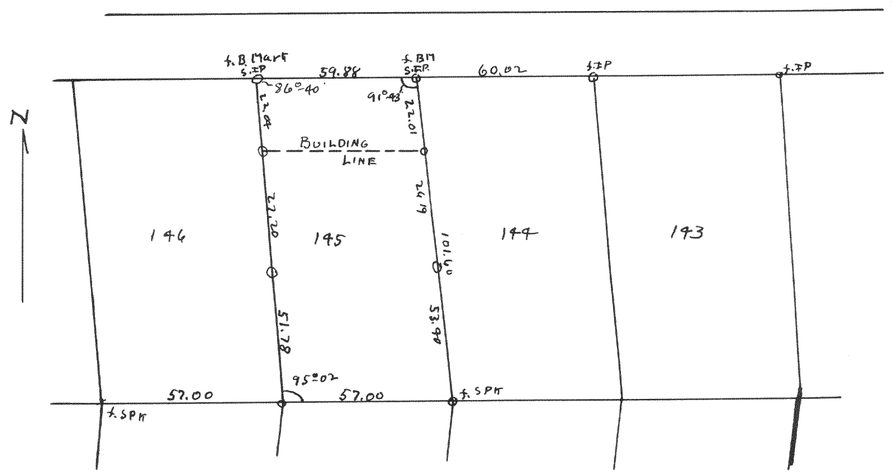

Plat of survey of Lot 145 Cedar Point Park 2nd addition in the Village of Williams Bay, Walworth County, Wisconsin
Sept 1945

Lloyd S Jensen
County Surveyor