
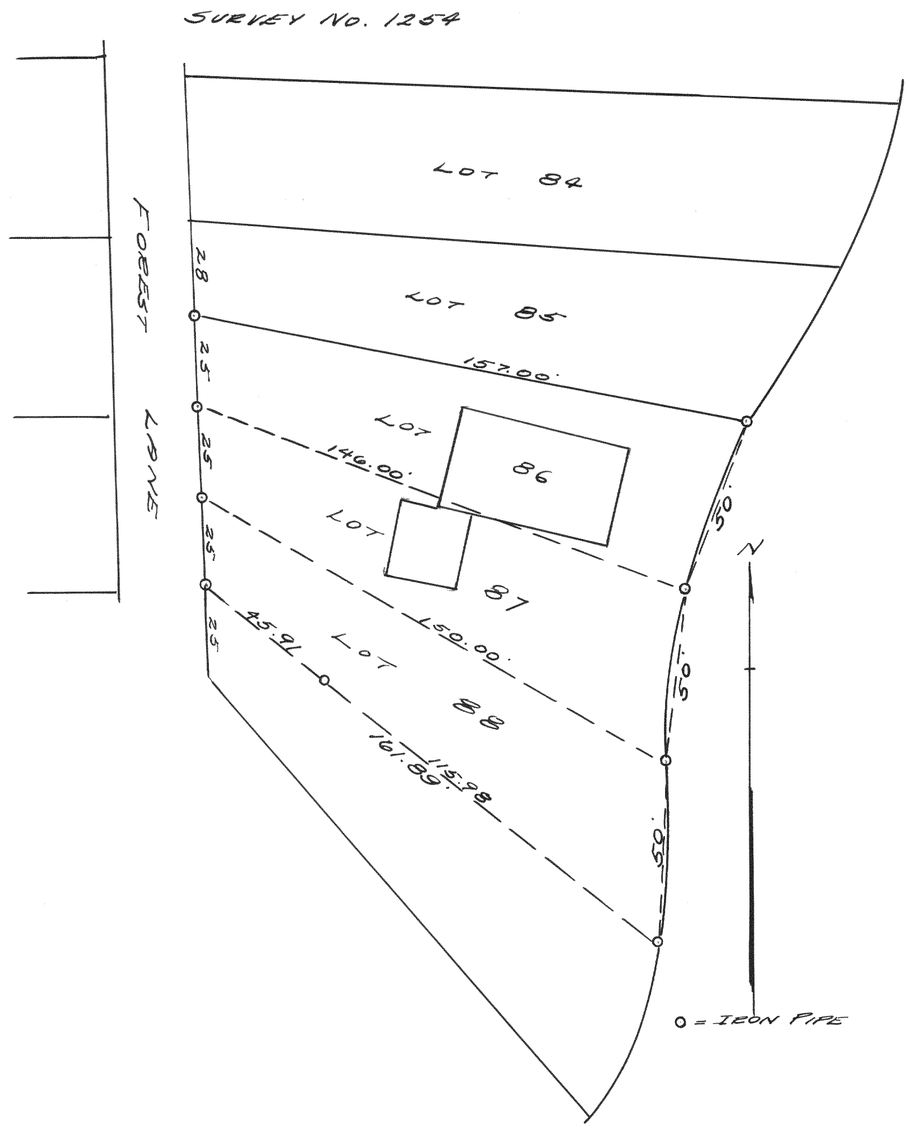


PLAT OF SURVEY OF LOTS 86 TO 88 OF BEUNA VISTA SUBD. IN THE VILLAGE OF FONTANA-ON-GENEVA LAKE, WALWORTH COUNTY, WISCONSIN.

OCT., 1941

Lloyd L. Jensen
R.E.J.

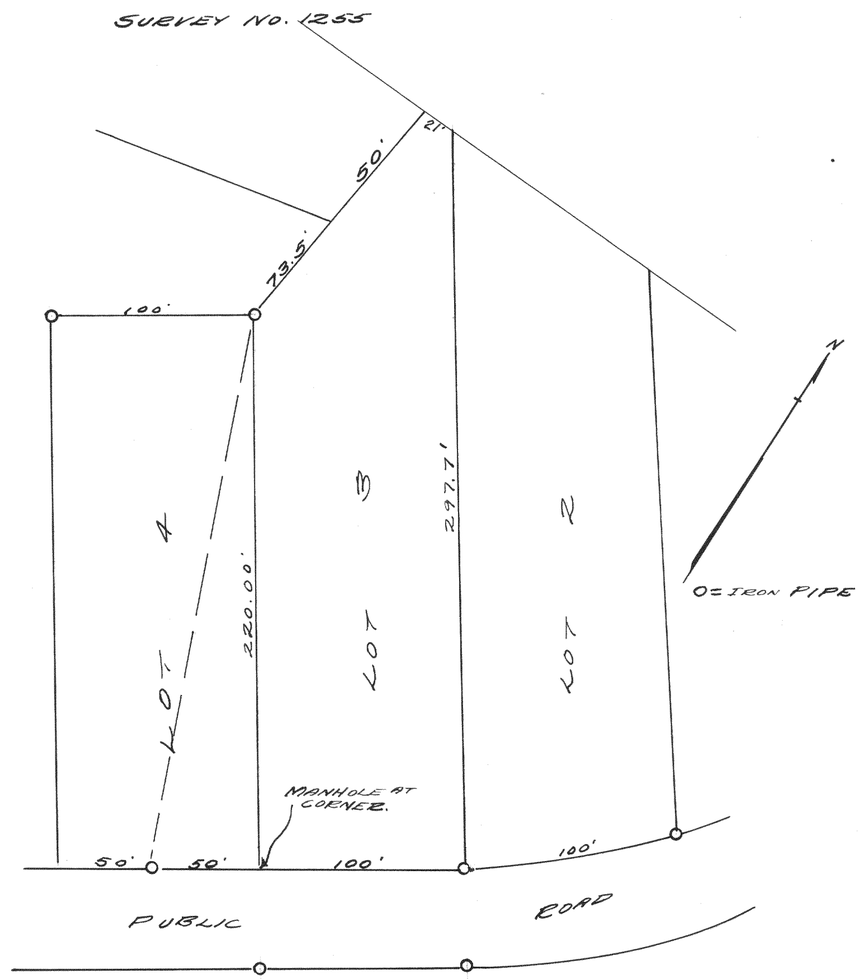

PLAT OF SURVEY OF LOT 3 OF UNIT ONE OF COUNTRY CLUB ESTATES IN THE VILLAGE OF FONTANA, WALWORTH COUNTY, WISCONSIN.

APRIL 14, 1941

Lloyd L. Jensen
R.E.J.