

390

1949

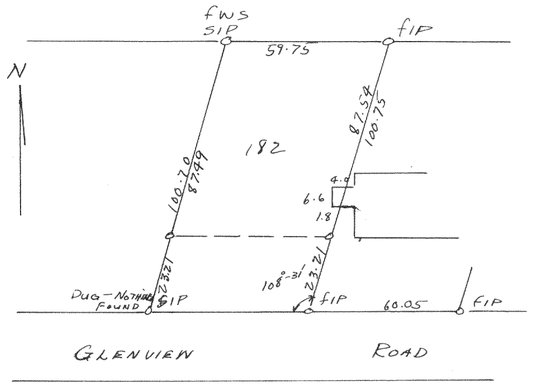

Plat of Survey of lots 182 Cedar Point Park 2nd Addition
Village of Williams Bay Walworth County
Aug. 1948
Lloyd L. Jensen
CWS


1950

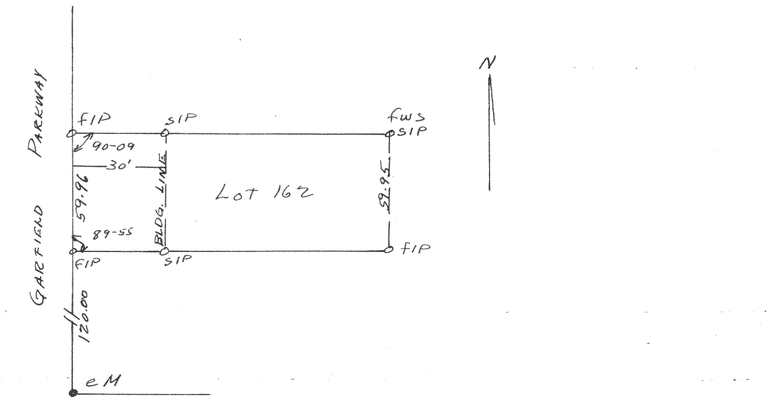

Plat of survey of Lot 162 Cedar Point Park Subdivision
Village of Williams Bay Walworth County
Aug 1948
Lloyd L. Jensen
CWS


NE COR SEC 1

1951

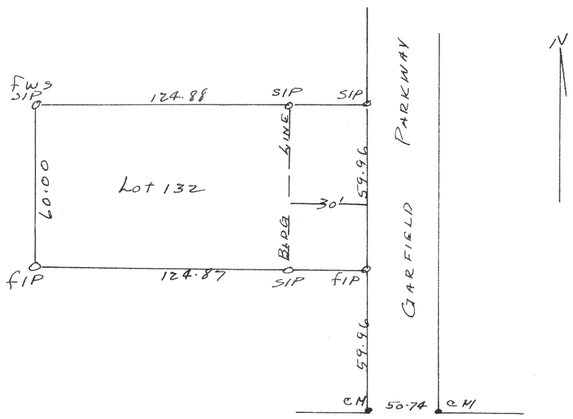

Plat of Survey of lot 132 Cedar Point Park Subdivision
in the Village of Williams Bay Walworth County
Aug 1948

1953

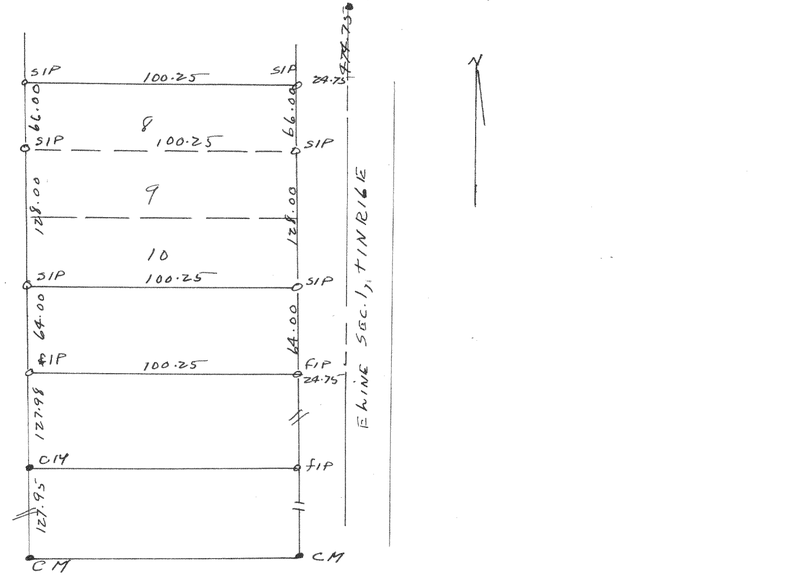

Plat of Survey of lots 8, 9, 10 of William H. Frances Subdivision
in Village of Williams Bay, Walworth County
Aug 1948
Lloyd L. Jensen
CWS