

#1954

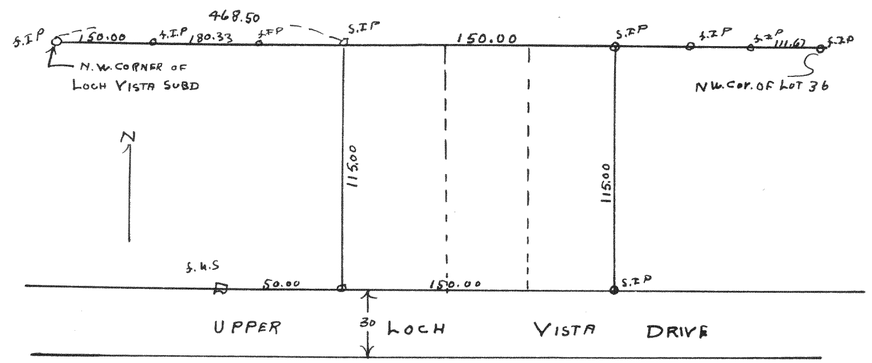

Plat of survey of lots 4, 5 & 6 of Loch Vista Subdivision No 1
Village of Williams Bay, Walworth County, Wisc
July 1998

Lloyd S Jensen
County Surveyor


#1955

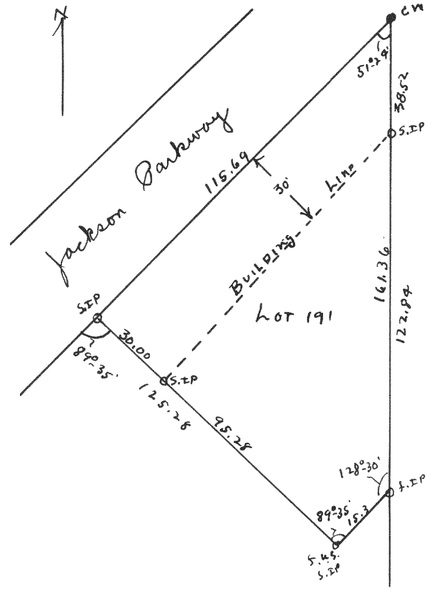

Plat of survey of Lot 191 Cedar Point Park subdivision located in the Village of Williams Bay Walworth County, Wisc
June 5, 1998

Lloyd S Jensen
County Surveyor


#1956

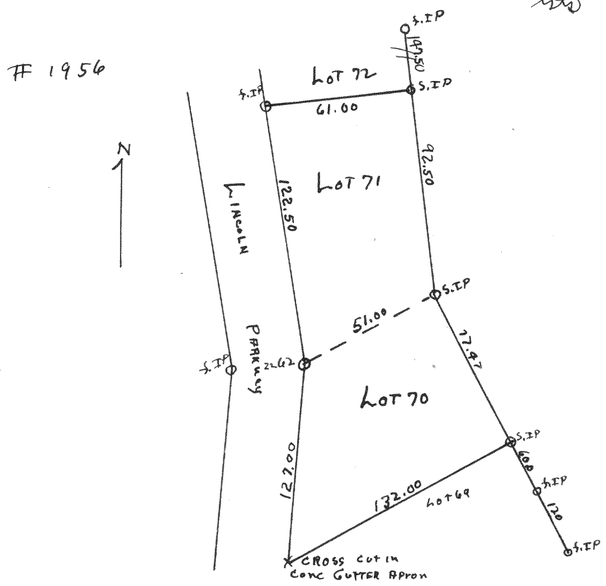

Plat of survey of lots 70 & 71 Cedar Point Park in the
Village of Williams Bay Walworth County, Wisconsin
August 1998

Lloyd S Jensen
County Surveyor

#1957

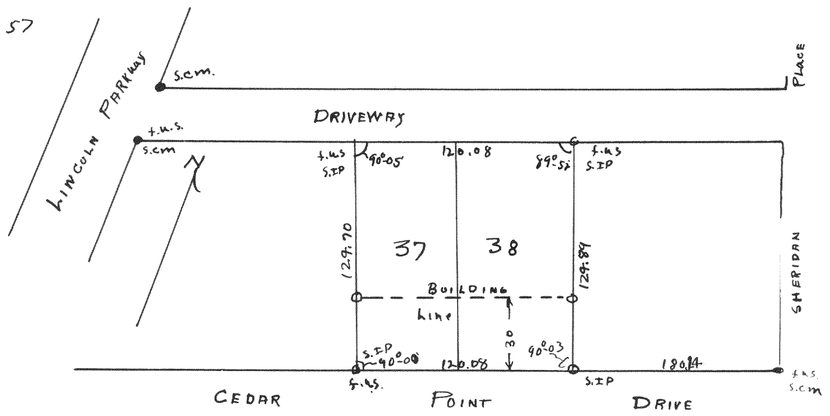

Plat of survey of lots 37 & 38 Cedar Point Park in the
Village of Williams Bay Walworth County Wisconsin
June 5, 1998

Lloyd S Jensen
County Surveyor