

1958

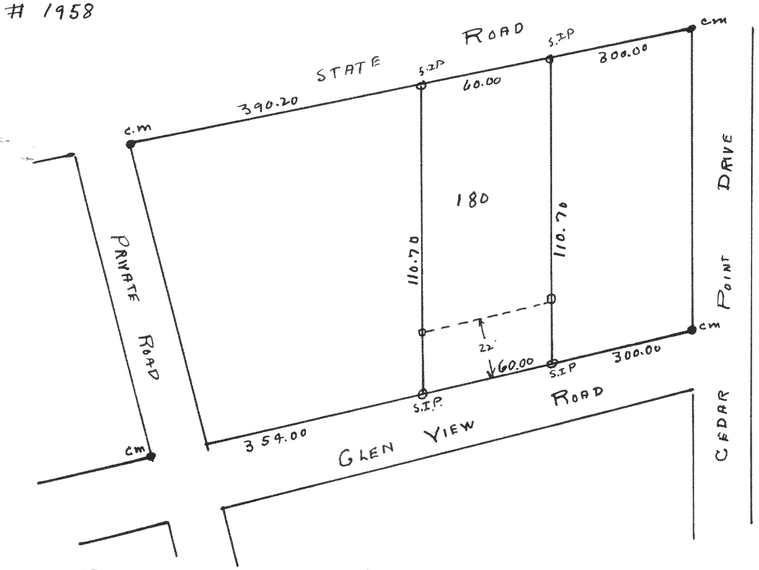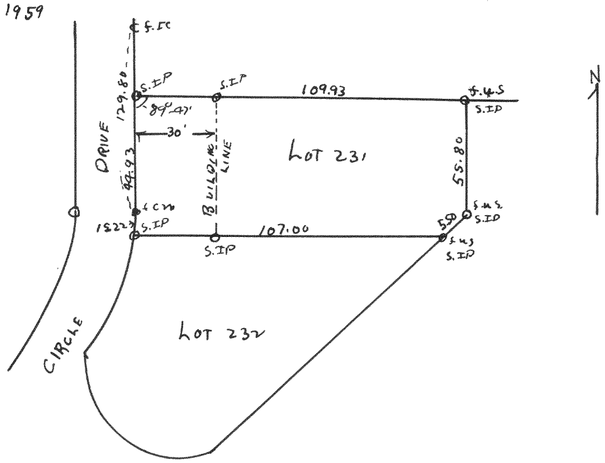

Plat of survey of lot 180 of the 2nd addition to Cedar Point Parks subdivision in the Village of Williams Bay
April 5, 1948
Lloyd S Jensen (SEAL)
county surveyor

1959


S.IP
109.93
S.I.P
S.I.P
S.I.P