

1968

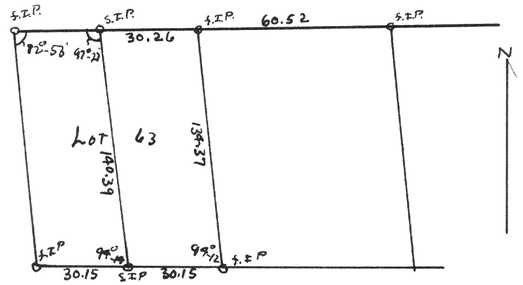

Plat of Lot 63 Lockwoods Subdivision in the Village of Williams Bay, Walworth County, Wisconsin
1948

Lloyd S Jensen
County Surveyor


1969

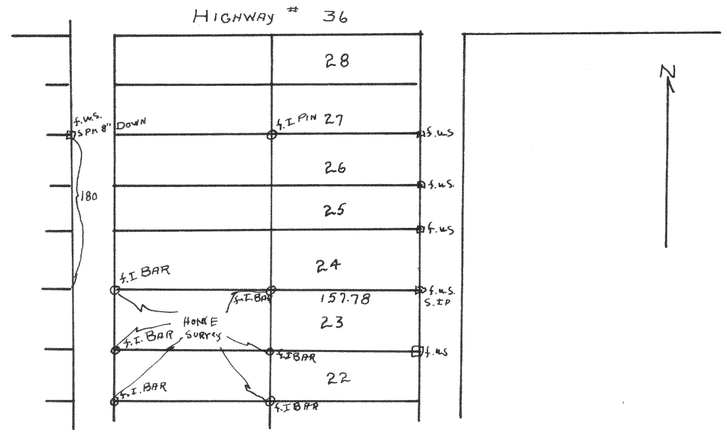

Plat of survey of the south half of lot 24 Block 3 in Harbor View subdivision. Village of Williams Bay, Walworth County, Wisconsin
Sept 22, 1948

Lloyd S Jensen
County Surveyor


1970

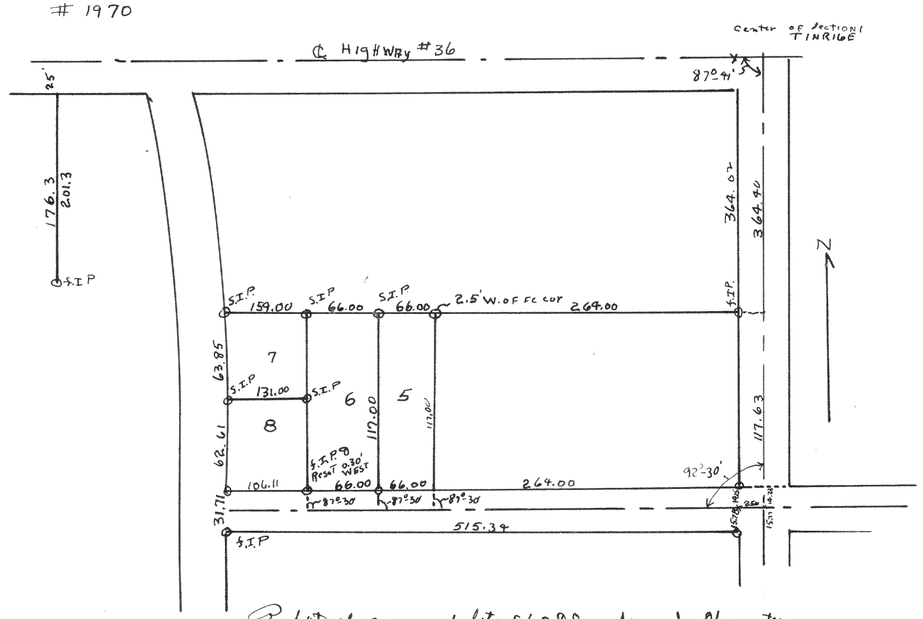

Plat of survey of lots 5,6,7&8 Second Observatory Subdivision Williams Bay, Walworth County, Wisc
October 1948

Lloyd S Jensen
County Surveyor

1971

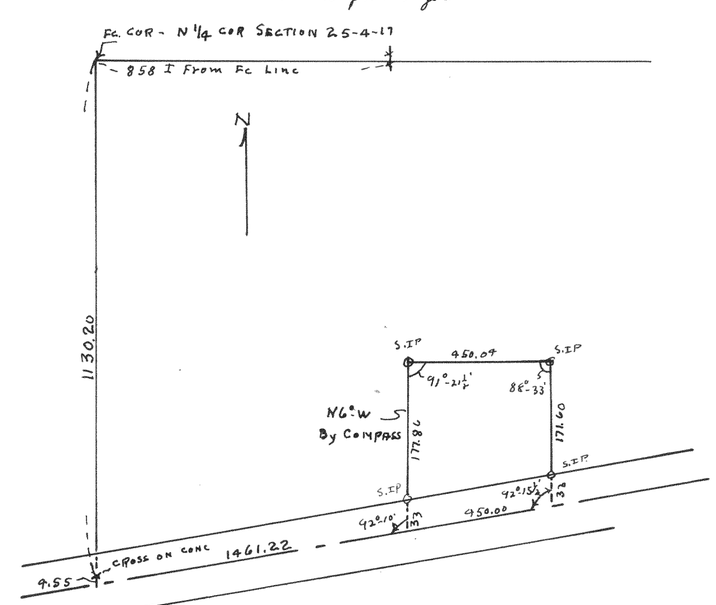

Plat of survey of a parcel of land located in the NE 1/4 OF Section 25 T4NR17E of Walworth County Wisconsin
February 17, 1948

Lloyd S Jensen
County Surveyor