1976

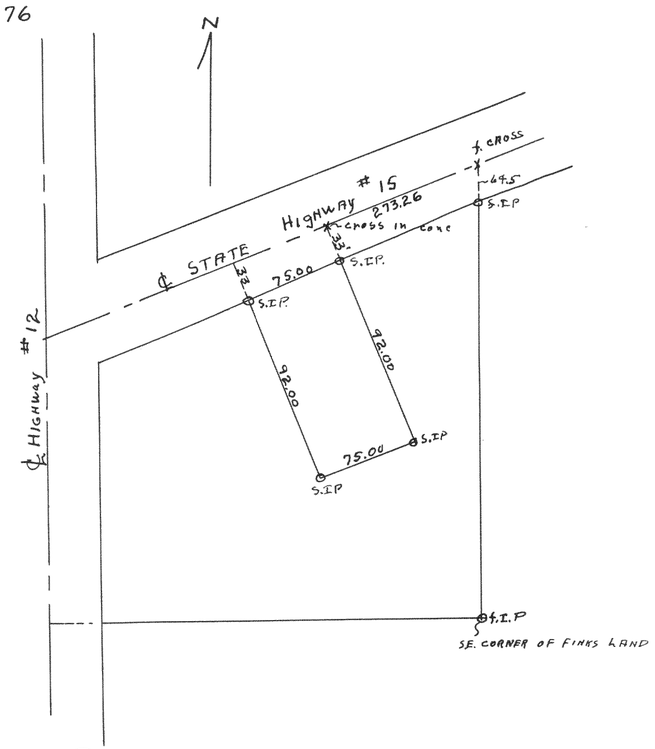

Plat of survey of a parcel of land located in the NW¼ of Section 18 T3 N R17 E of Walworth County Wisc
May 1948

Floyd S Jensen
County Surveyor

1977

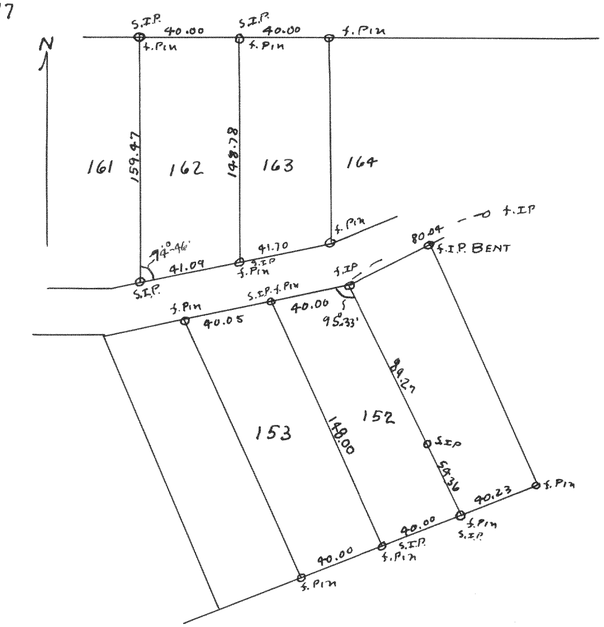

Plat of survey of 152 & 162 in Krumhaar's 2nd addition located in section 31, T2NR16E of Walworth County Wisc
May 7, 1948

Floyd S Jensen
County Surveyor