

1978

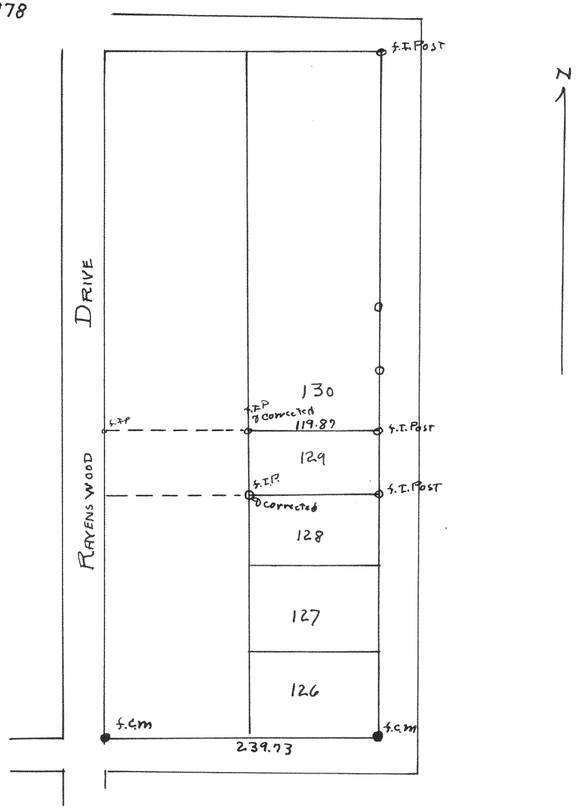

Plat of survey of Lot 129 in Krumbaar's 2nd Addition located in Section 31, T2N R16E Walworth County Wisc
May 8, 1998

Lloyd S Jensen
County Surveyor

1979

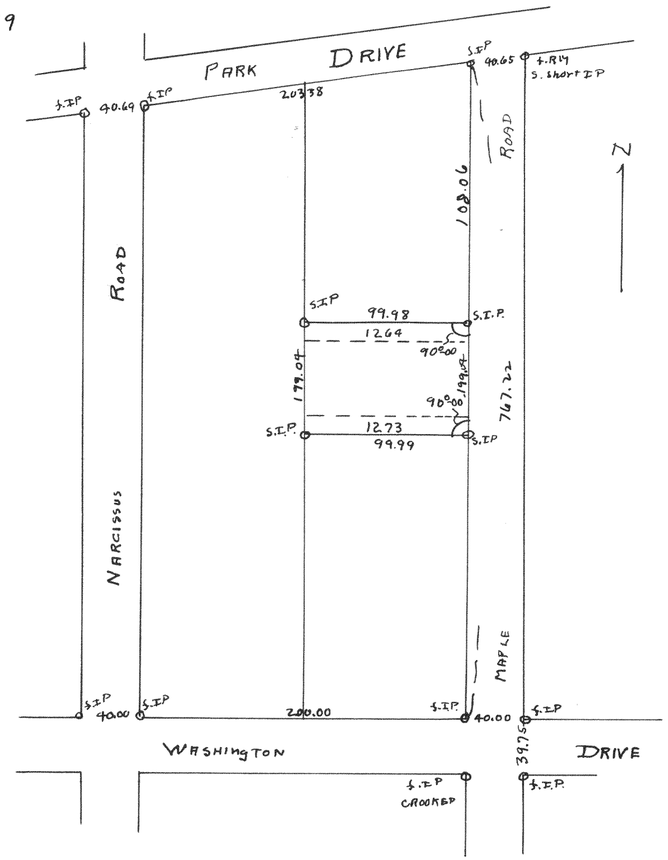

Plat of survey of lots 1264-1273 Lake como Beach Subdivision Walworth County Wisconsin
May 8, 1998

Lloyd S Jensen
County Surveyor