

1980

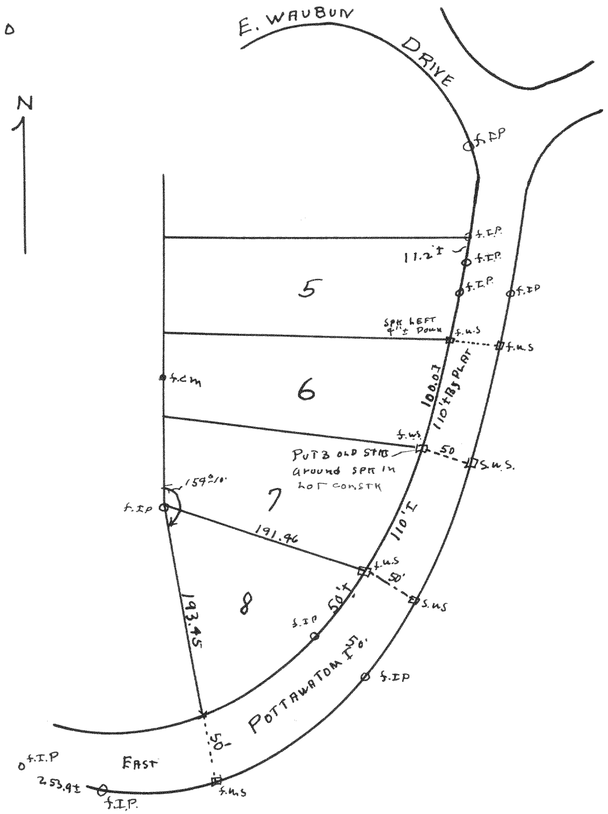

Plat of survey of East Pottawatomie Road line located in Country Club Estates in the Village of Fontana, Walworth County Wisconsin
May 19, 1998

Floyd L Jensen
County Surveyor

1981

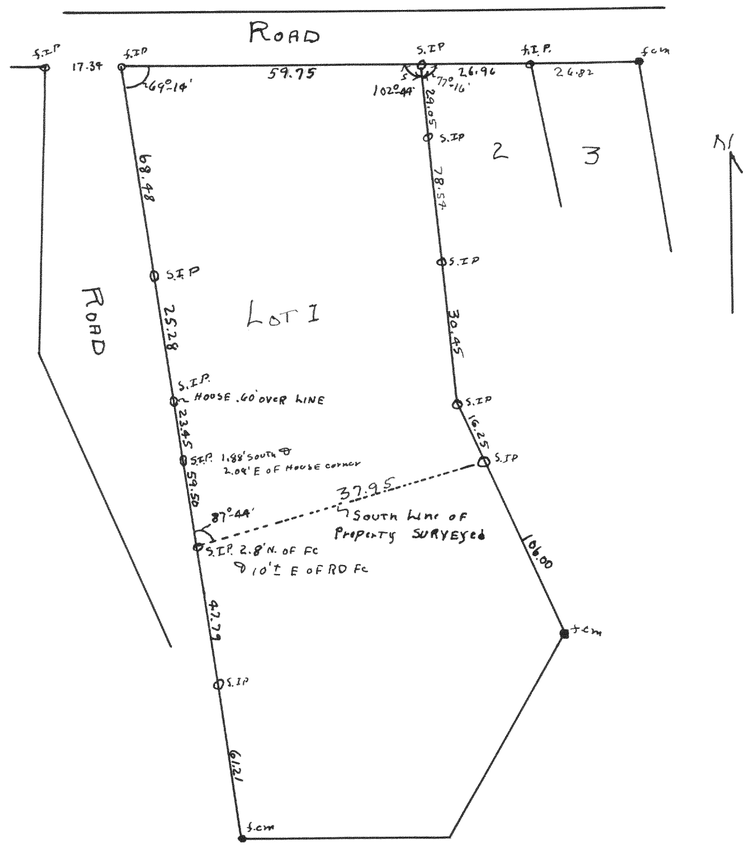

Plat of survey of part of lot 1 of Mellow Point Park Addition located in the SE¼ of Section 29, T2N R16E of Walworth County Wisconsin
Aug 24, 1998

Floyd L Jensen
County Surveyor