1980

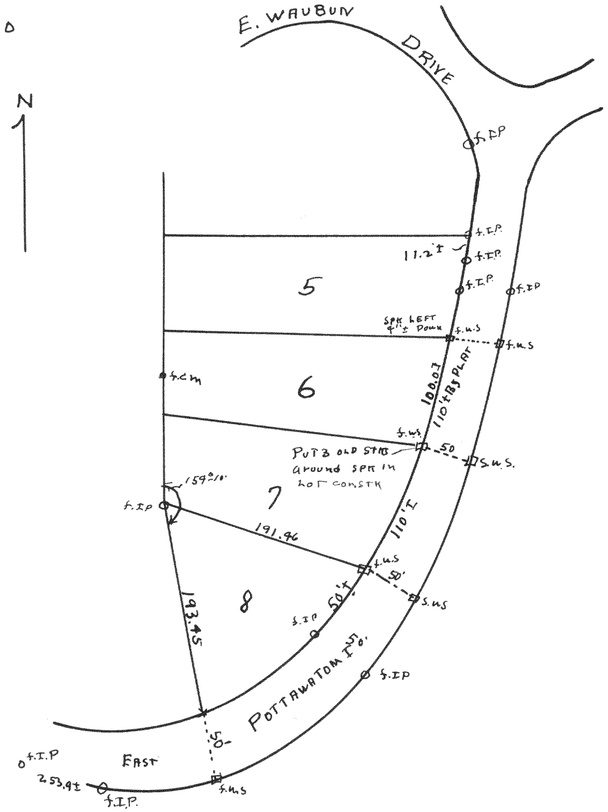

Plat of survey of East Pottawatomie Road line located in Country Club Estates in the Village of Fontana, Walworth County Wisconsin
May 19, 1998

Floyd L Jensen
County Surveyor

1981

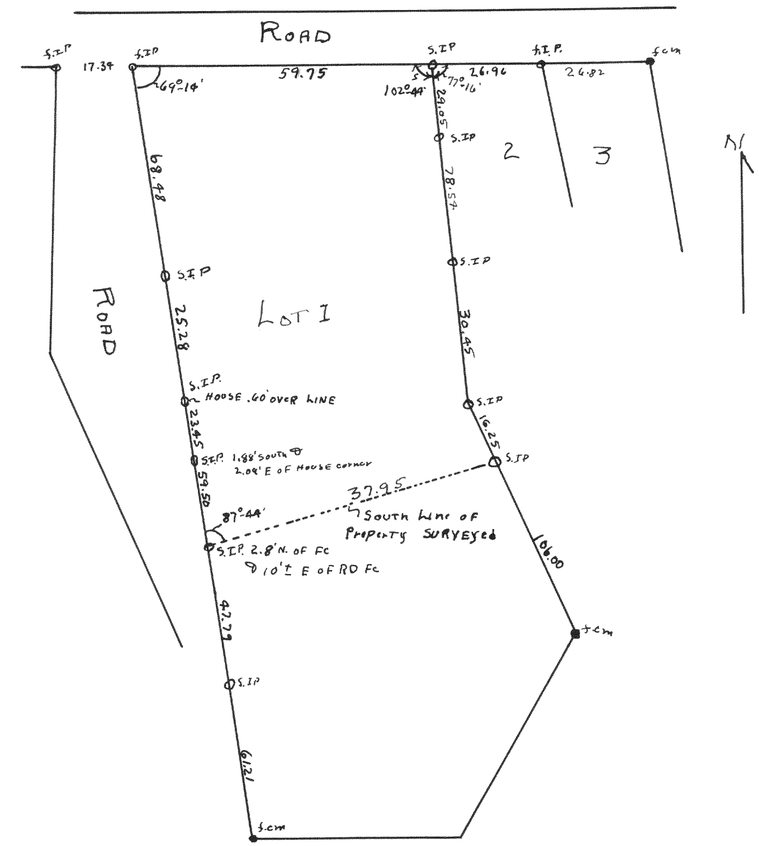

Plat of survey of part of lot 1 of Mellow Point Park Addition located in the SE1/4 of Section 29, T2NR16E of Walworth County Wisconsin
Aug 26, 1998

Floyd L Jensen
County Surveyor