
#1982

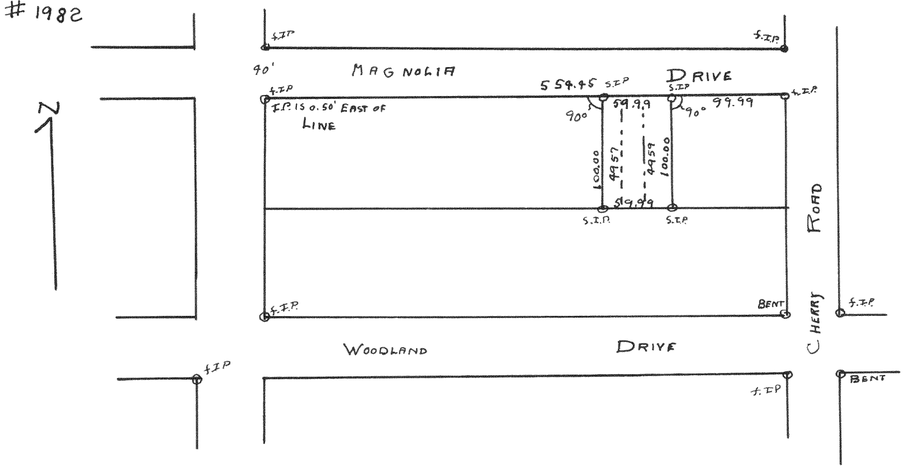


Plat of survey of lots 4957 to 4959 Lake Como Beach Subdivision located in sections 21 & 22 T2N R17E of Walworth County, Wisc.

November 10, 1948

Lloyd S Jensen
County Surveyor

#1983

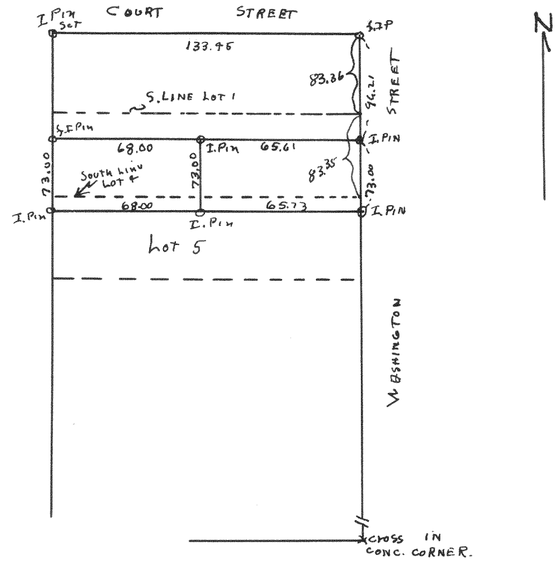

Plat of survey of part of lots 4 & 5 Block 20 of the Original Town - City of Elkhorn, Walworth County Wisconsin

April 29, 1948

Lloyd S Jensen
County Surveyor