
1984

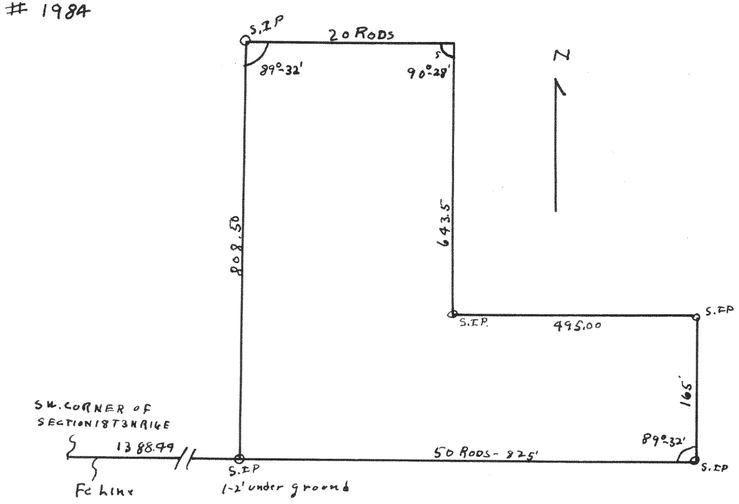


Plat of survey of a parcel of land located in the SW 1/4 of Section 18 T3N R16E Walworth County Wisconsin

April 11 1948

Lloyd S Jensen (SEAL)
County Surveyor

1985

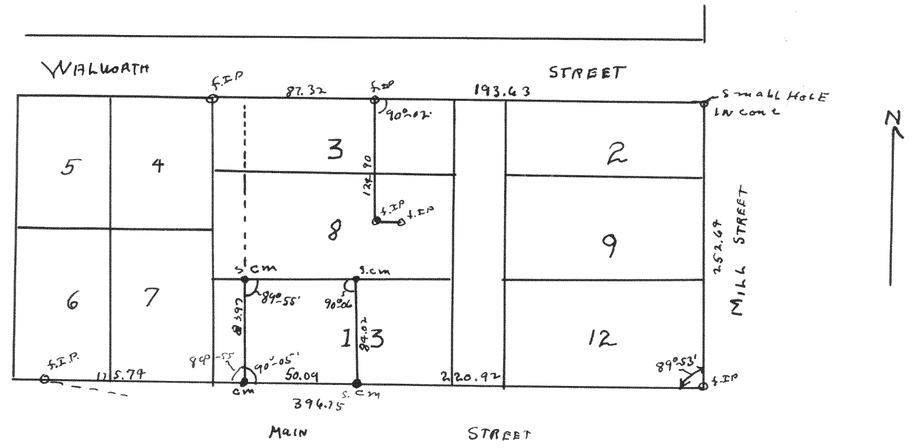


Plat of survey of part of Lot 13 of the original Plat of the Village of Geneva city Walworth County Wisconsin

1948

Lloyd S Jensen
County Surveyor

1986

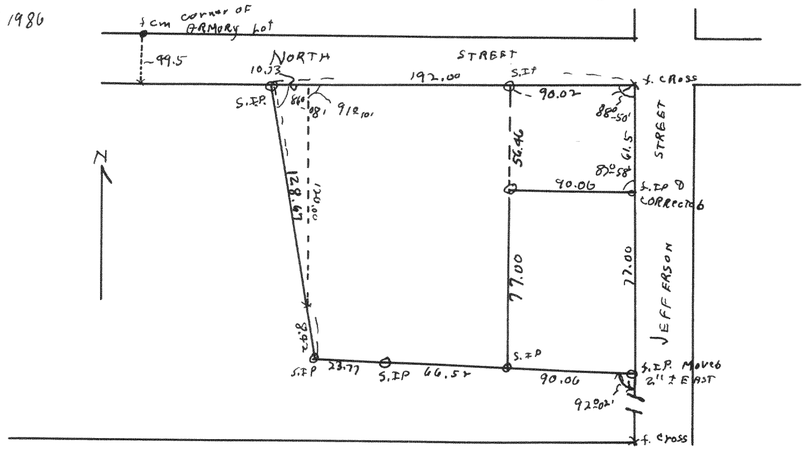


Plat of survey of land located in lots 8, 9 & 10 of Wm Burgis addition in the City of ~~Elkhorn~~ Delavan, Walworth County Wisc

1948

Lloyd S Jensen
County Surveyor

1987

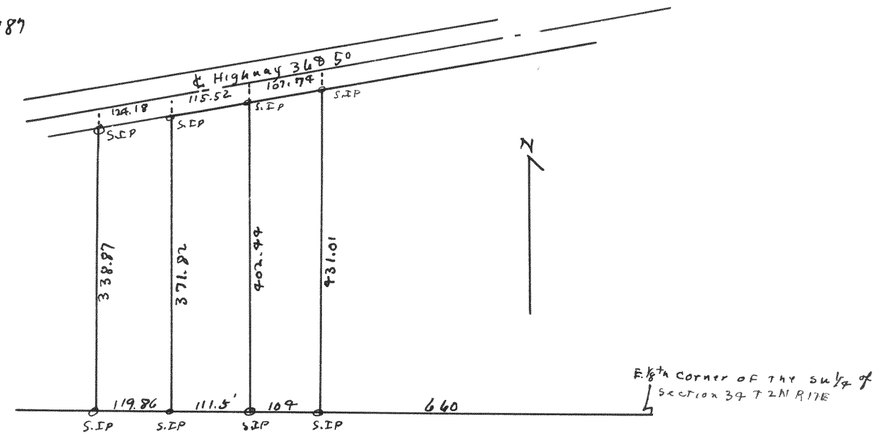

Plat of survey of parcels of land located in the SW 1/4 of Section 34 T2N R11E of Walworth County Wisconsin

July 8, 1948

Lloyd S Jensen
County Surveyor